T. 17 S., R. 20 E., W.M.

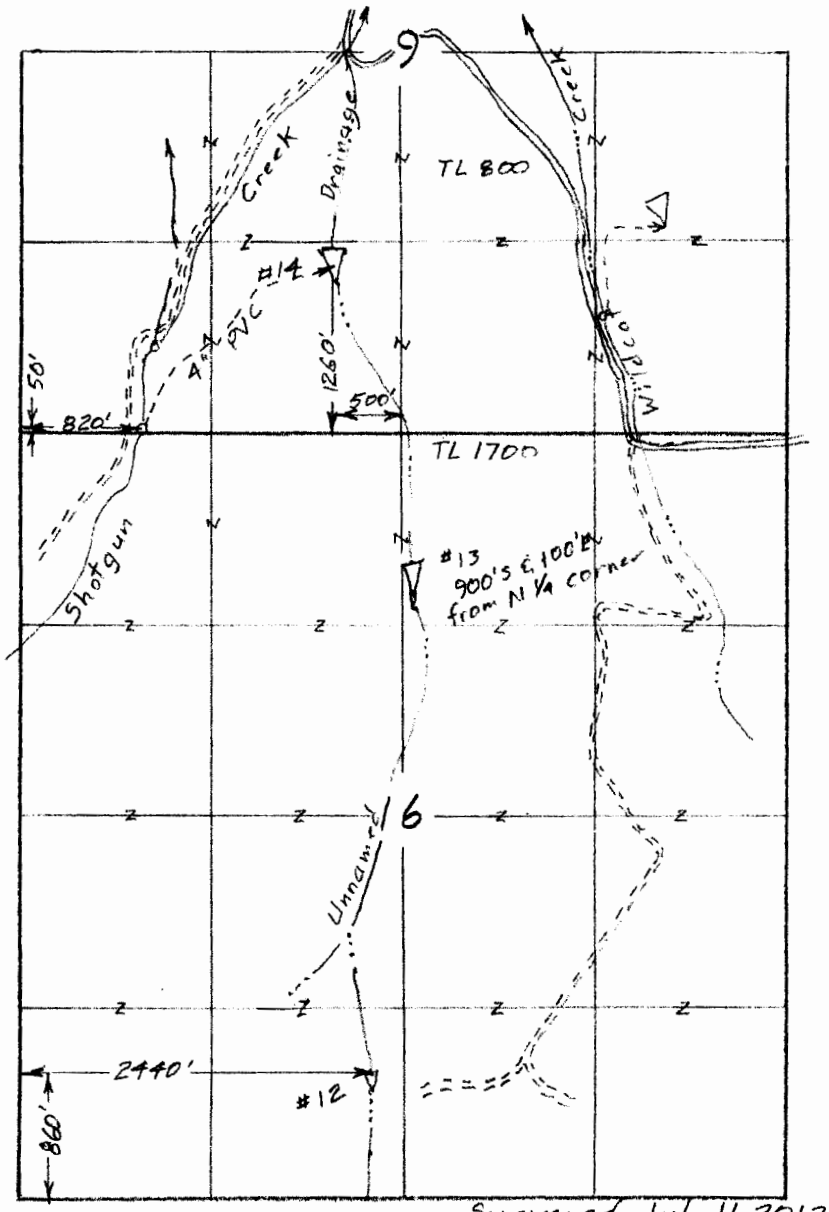

Scale 1" = 1320'
(4" = 1 mile)

#14
App R-87096
Permit R-14642

#13
App R-87095
Permit R-14641

#12
App R-87094
Permit R-14640

Surveyed July 11, 2012

RECEIVED BY OWRD

FEB 03 2014

SALEM, OR

Claim of Beneficial Use Map
for
SHOTGUN RANCH, LLC

Certified Water Right Examiner
Bruce A. Estes
Nov. 19, 1987
STATE OF OREGON
Renewal Dec 31, 2015

This map is for the purpose of locating a water right only and has no intent to provide legal dimensions or the location of property lines.

ESTES SURVEYS, LLC
~~PO Box 17510~~
~~Salem, OR 97305-7510~~
~~(503) 585-7503~~
60382 Arnold Rd
Bend, OR 97702
(541) 382-7391