


# CLAIM OF BENEFICIAL USE

SECTION 11 T1N R2W W.M.  
WASHINGTON COUNTY, OREGON

APPLICATION G-15664  
PERMIT G-15334  
SURVEYED MARCH 27, 2008

FOR:  
CASCADIAN NURSERY  
8900 NW DICK RD.  
HILLSBORO, OR 97124

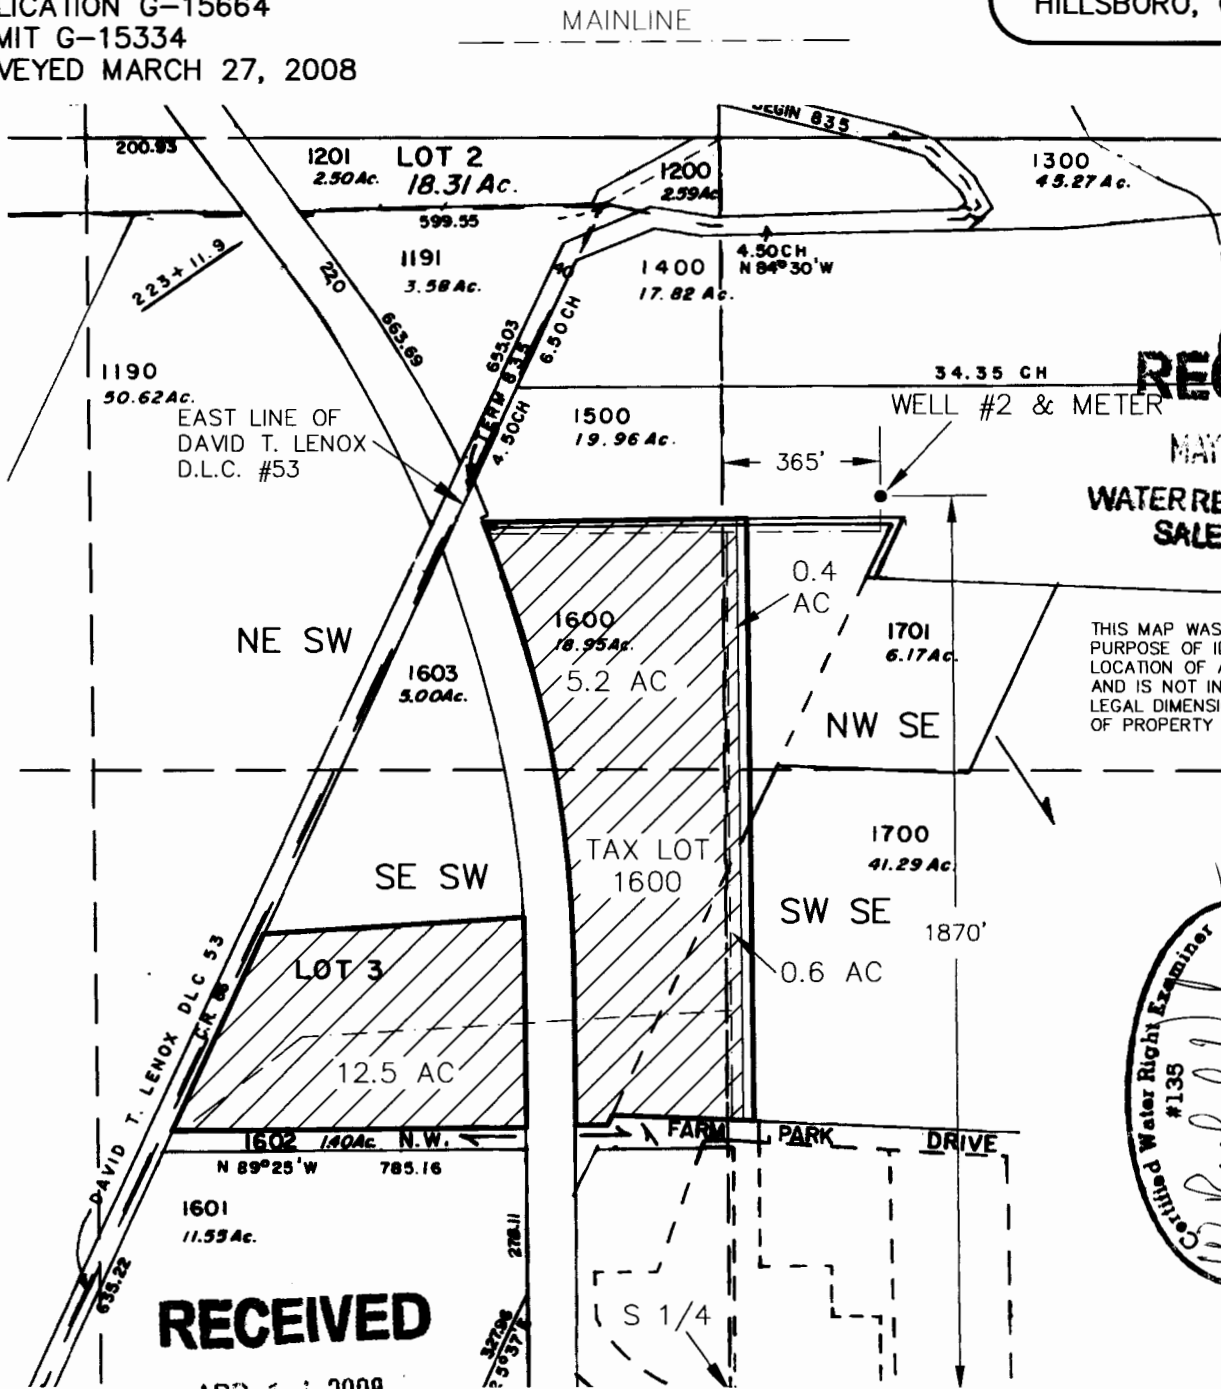

**RECEIVED**

MAY 02 2008

WATER RESOURCES DEPT  
SALEM OREGON


THIS MAP WAS PREPARED FOR THE  
PURPOSE OF IDENTIFYING THE  
LOCATION OF A WATER RIGHT ONLY  
AND IS NOT INTENDED TO PROVIDE  
LEGAL DIMENSIONS OR LOCATION  
OF PROPERTY OWNERSHIP LINES.



**RECEIVED**

APR 14 2008

WATER RESOURCES DEPT OF MAP DATA IS FINAL  
SALEM OREGON OF SURVEY FOR CERTIFICATES,  
ASSESSORS MAP, AND MICROSOFT  
VIRTUAL EARTH PHOTO.

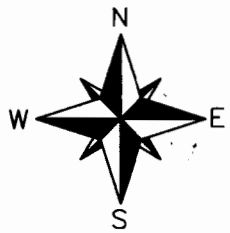

1 inch = 400 ft.



Project: 305-2-029  
Drawing: 3052029-COBU.dwg  
By: CVB/WRV  
Date: 4-01-08