
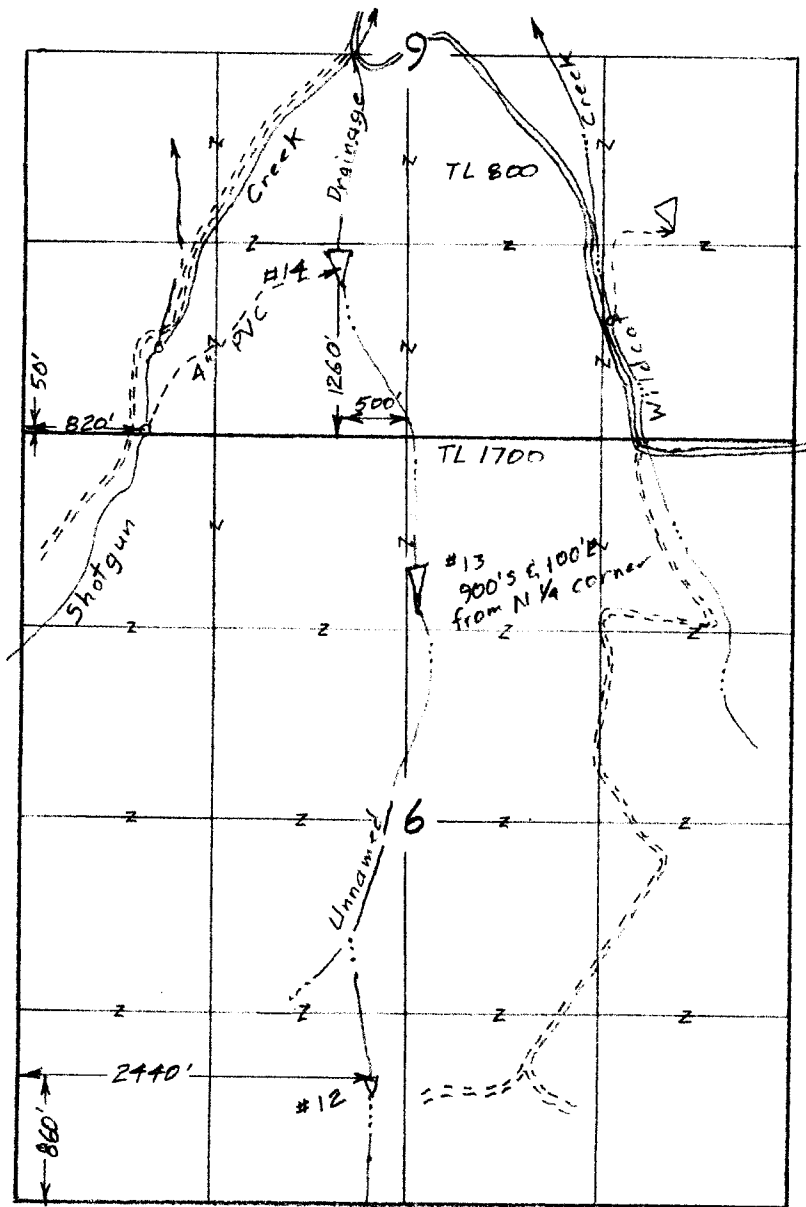


T. 17S., R. 20E., W. M.

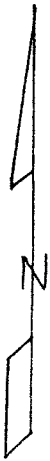

Scale 1" = 1320'  
(4" = 1 mile)

#14  
App R-87096  
Permit R-14642

#13  
App R-87095  
Permit R-14641

#12  
App R-87094  
Permit R-14640


RECEIVED BY OWRD

FEB 03 2014

SALEM, OR

Surveyed July 11, 2012

Claim of Beneficial Use Map  
for  
SHOTGUN RANCH, LLC

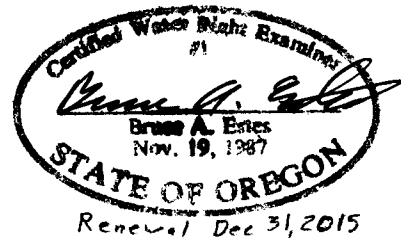

This map is for the purpose of locating a water right only and has no intent to provide legal dimensions or the location of property lines.

**ESTES SURVEYS, LLC**

~~PO Box 17516~~  
Salem, OR 97306-7516  
(503) 585-7500

60382 Arnold Rd  
Bend, OR 97702  
(541) 382-7391