


FINAL PROOF SURVEY MAP IN THE NAME OF LAURENCE T. & LYNNE M. DILTZ


CERTIFICATE No. 9687 (COW CREEK DECREE)

T - 8895

SECTION 22, TOWNSHIP 32 SOUTH, RANGE 6 WEST, W.M. RECEIVED

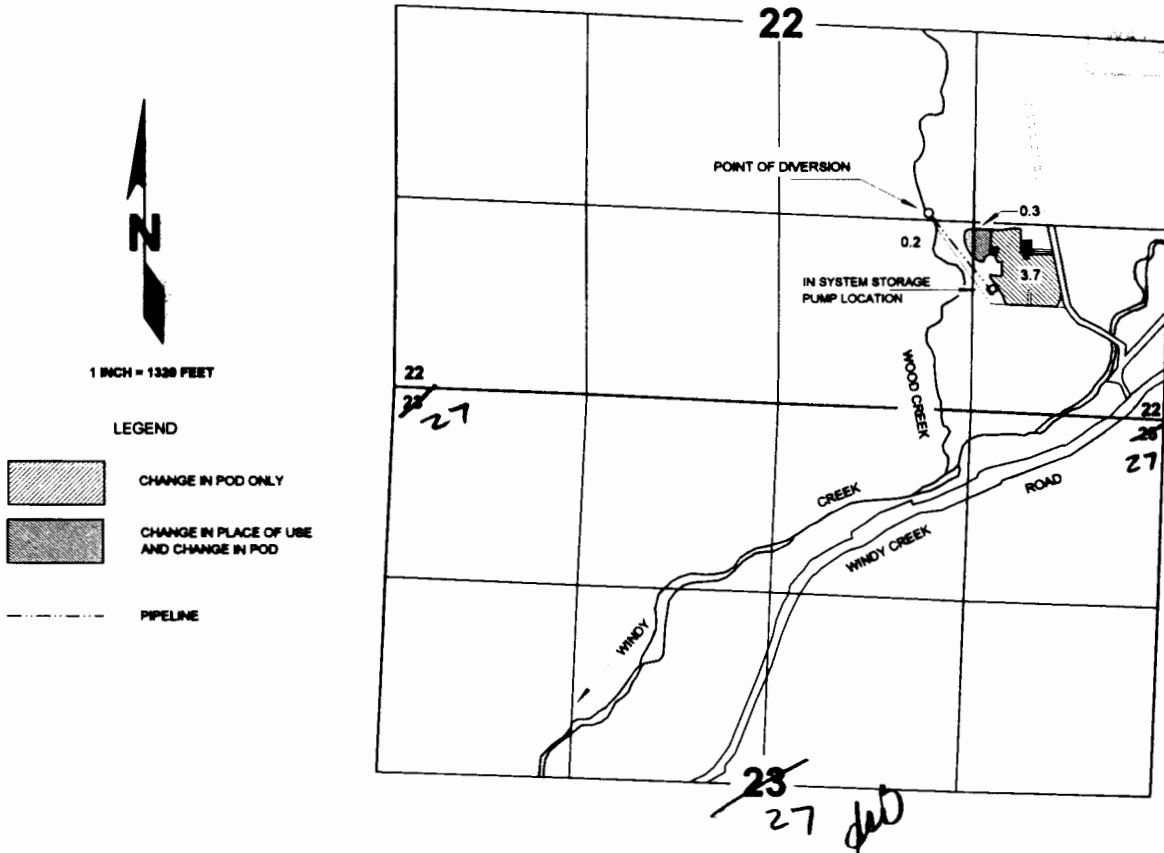

THE POINT OF DIVERSION IS LOCATED 1315 FEET NORTH AND 1035 FEET EAST FROM THE SOUTH QUARTER CORNER OF SECTION 22; BEING WITHIN THE NW¼ SE¼ OF SECTION 22, TOWNSHIP 32 SOUTH, RANGE 6 WEST, W.M.; DOUGLAS COUNTY.

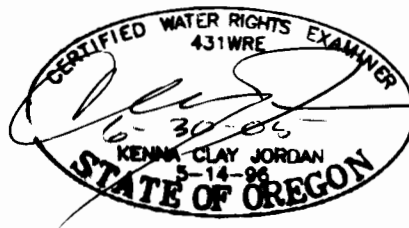

THE PURPOSE OF THIS MAP IS TO IDENTIFY THE LOCATION OF THE WATER RIGHT. IT IS NOT INTENDED TO PROVIDE INFORMATION RELATIVE TO THE LOCATION OF PROPERTY OWNERSHIP BOUNDARY LINES.