


SALEM, OREGON

Memorandum No. P-84182

SEE MAP IN 39 9D

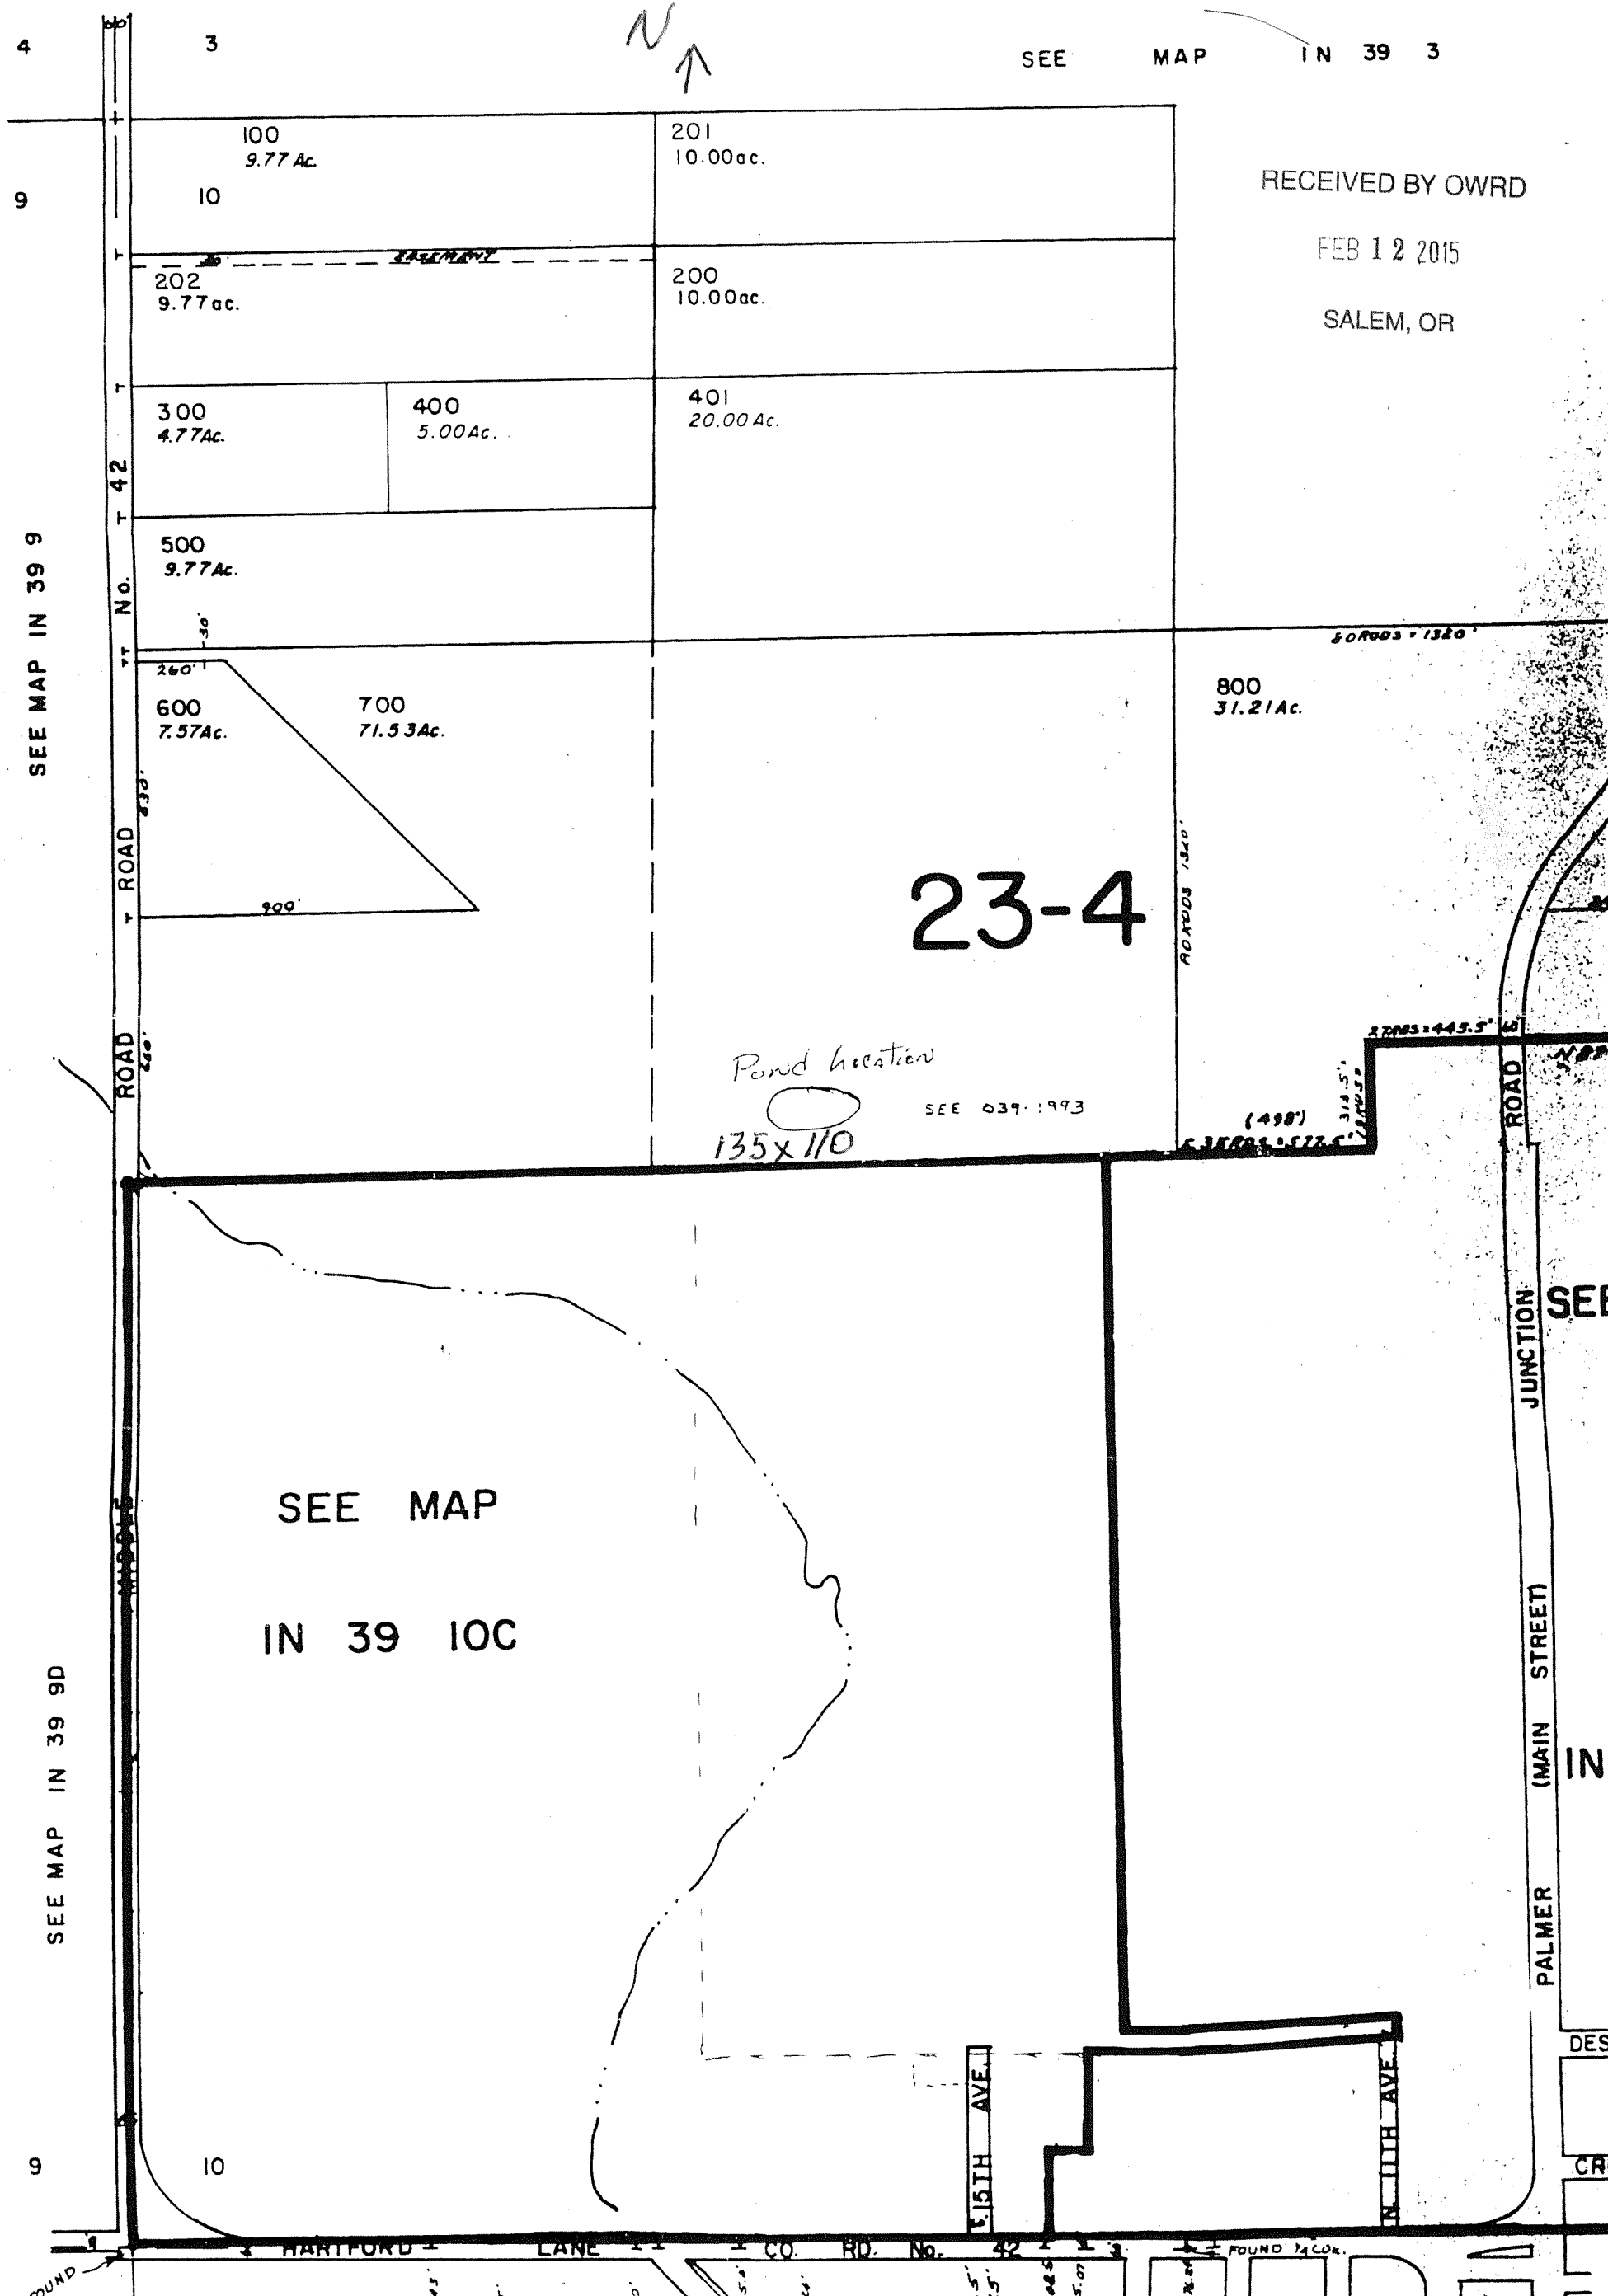

$$1'' = 400'$$

CANCELLED NO.
1100 THRU 2000

RECEIVED BY OWRD

FEB 12 2015

SALEM, OR

MAP IN 39 3

4

13

39

MAP

335

IN 39 10D

IN 39 10
& INDEX
ELGIN