


15 17 19 21

SCALE:
1" = 400'



**THIS MAP FOR ASSESSMENT
& TAXATION PURPOSES
ONLY**

35 1W 15

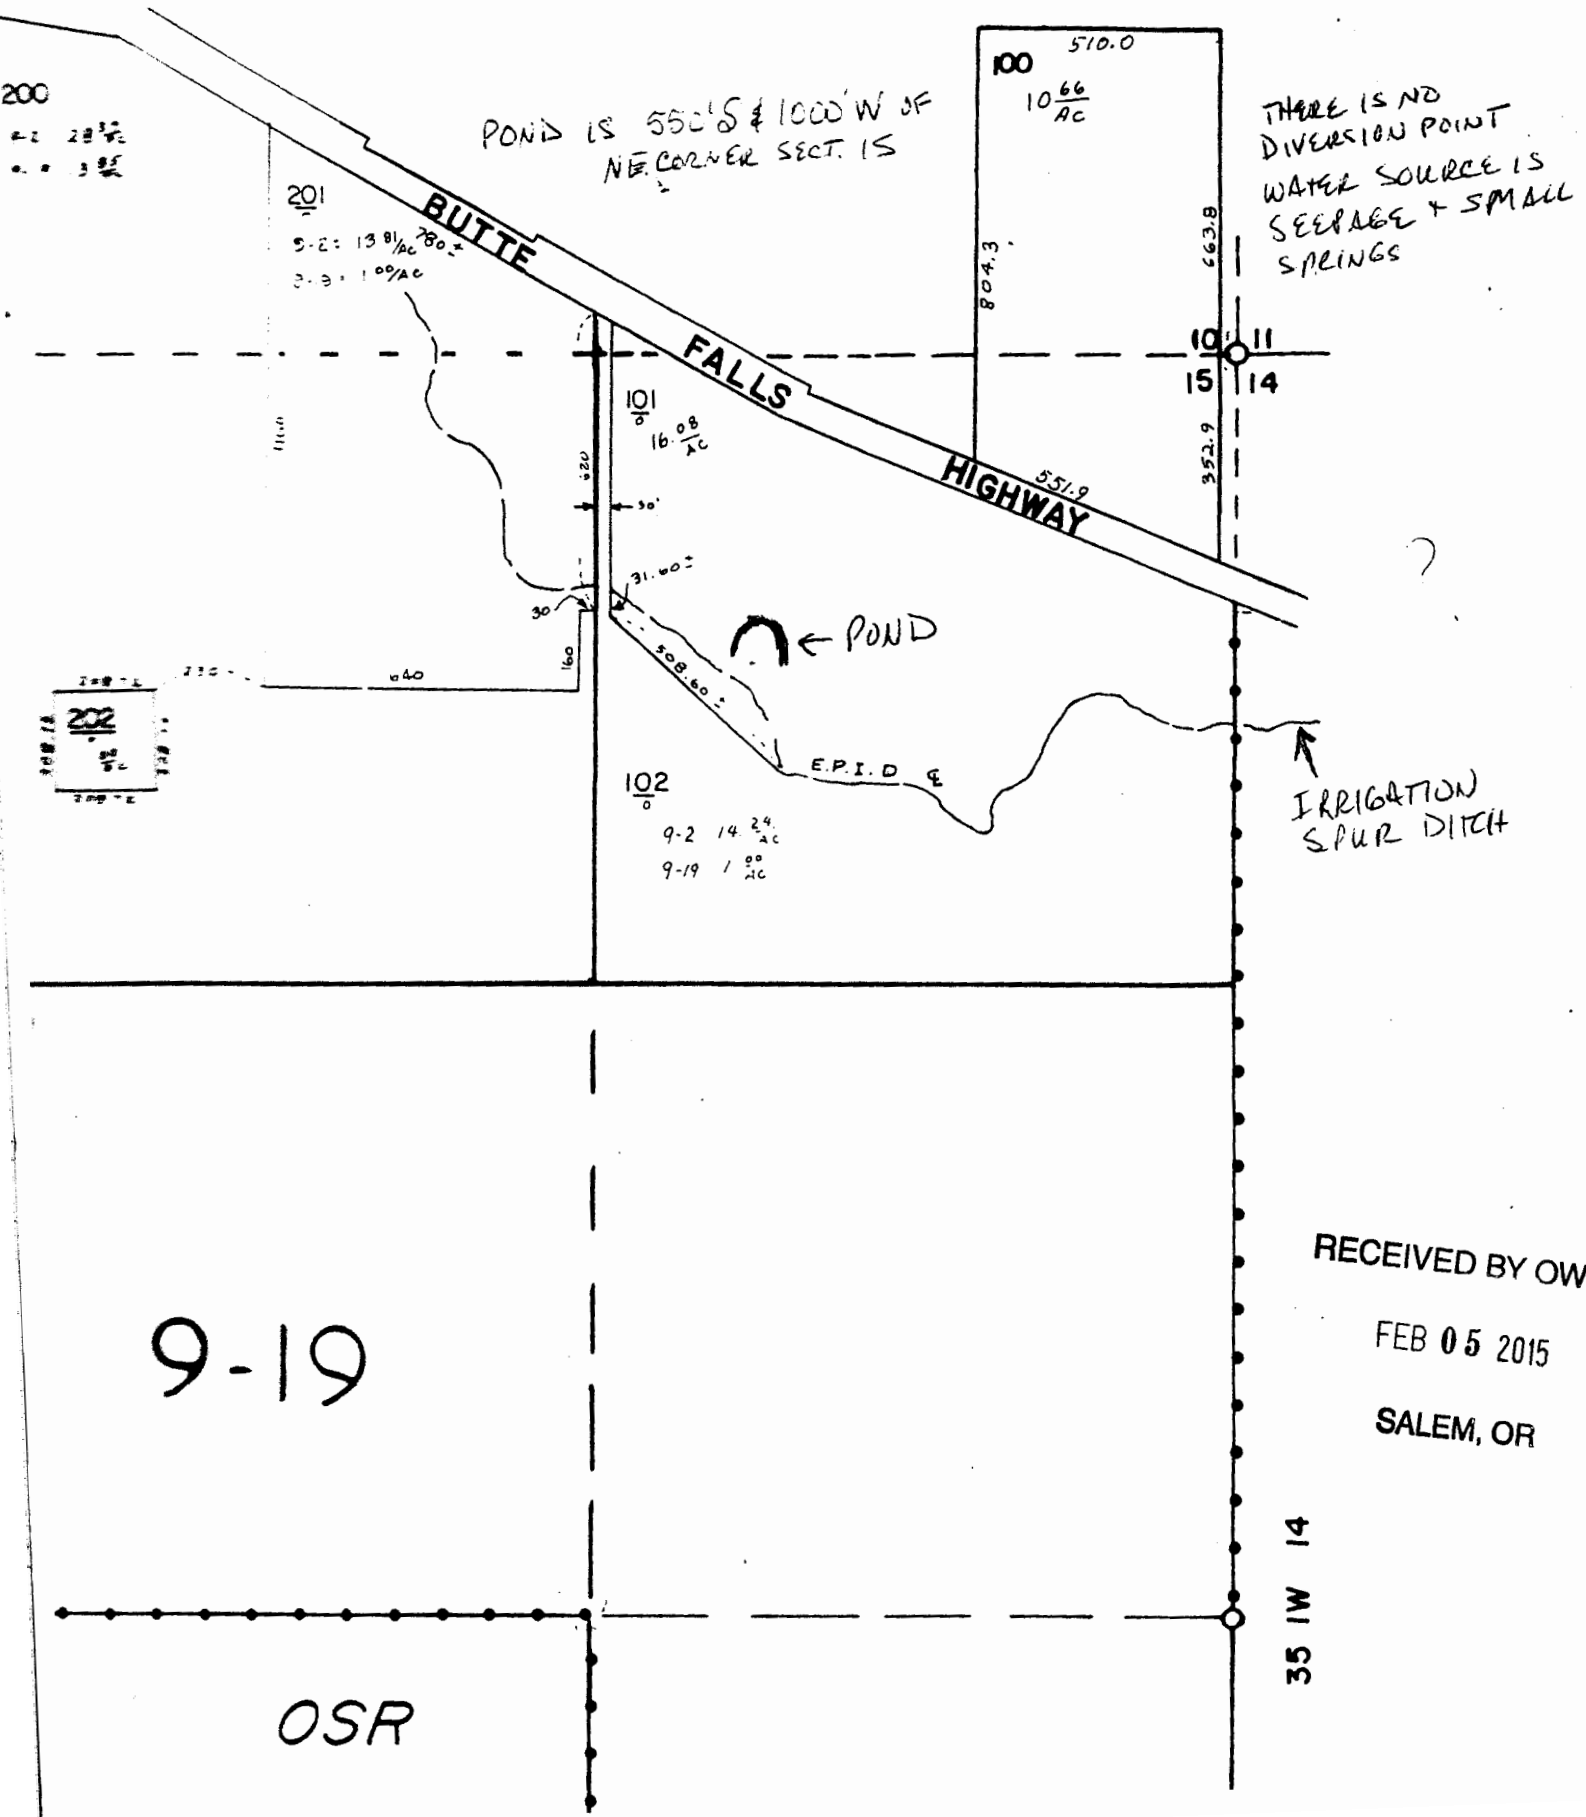

RECEIVED BY OWRI

FEB 05 2015

SALEM, OR