



T.34S.,R.1W.,W.M.

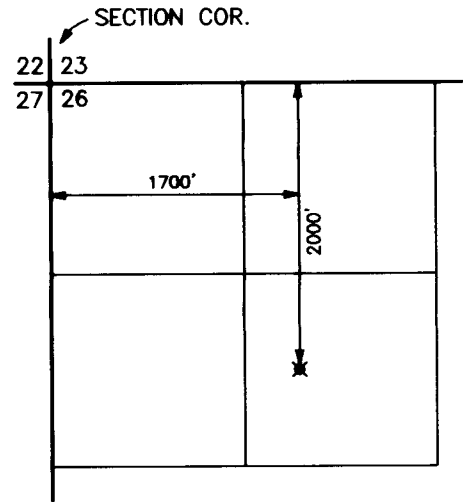

SCALE 1" = 400'

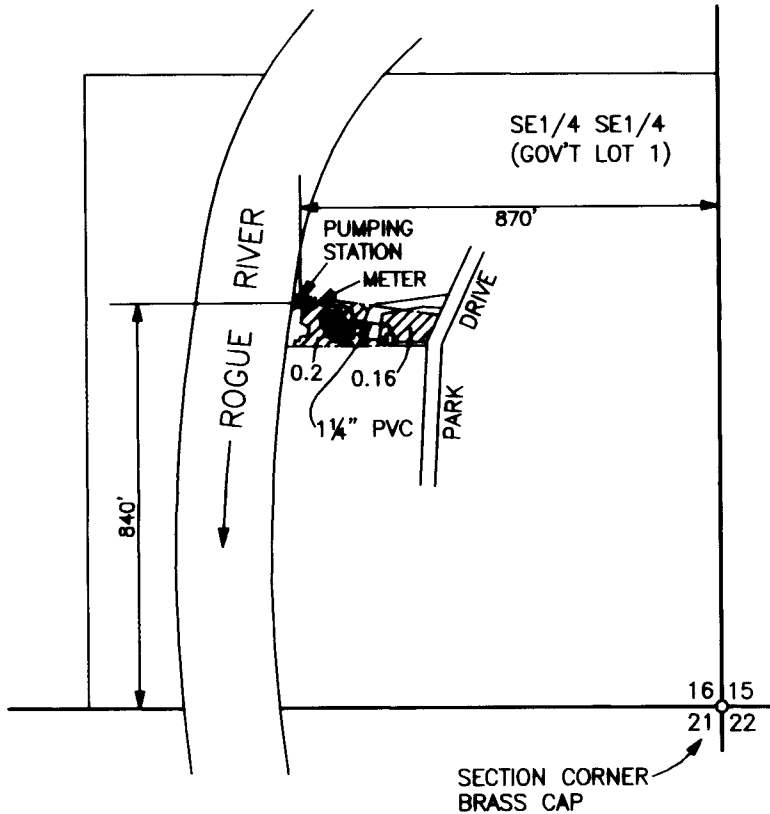

LOST CREEK RESERVOIR
POINT OF DIVERSION
T.33S.,R.1E.,W.M.
SCALE 1" = 1320'


CLAIM OF BENEFICIAL USE MAP

APPLICATION No. S-84667
PERMIT No. 53804

IN THE NAME OF:
GERALD AND NORMA ESKEW

NOTE: MAP PREPARED FOR
WATER RIGHT PURPOSES ONLY,
NOT FOR PROPERTY BOUNDARY
LOCATIONS.

RECEIVED
SEP 08 2005
WATER RESOURCES DEPT
SALEM, OREGON

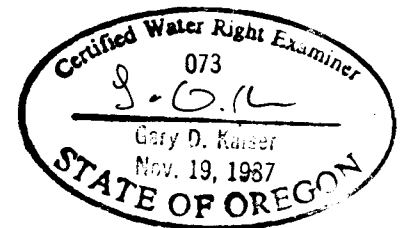

MAP PREPARED AUGUST 8, 2005 BY GARY D. KAISER