


T. 17S., R. 20 E., W.M.

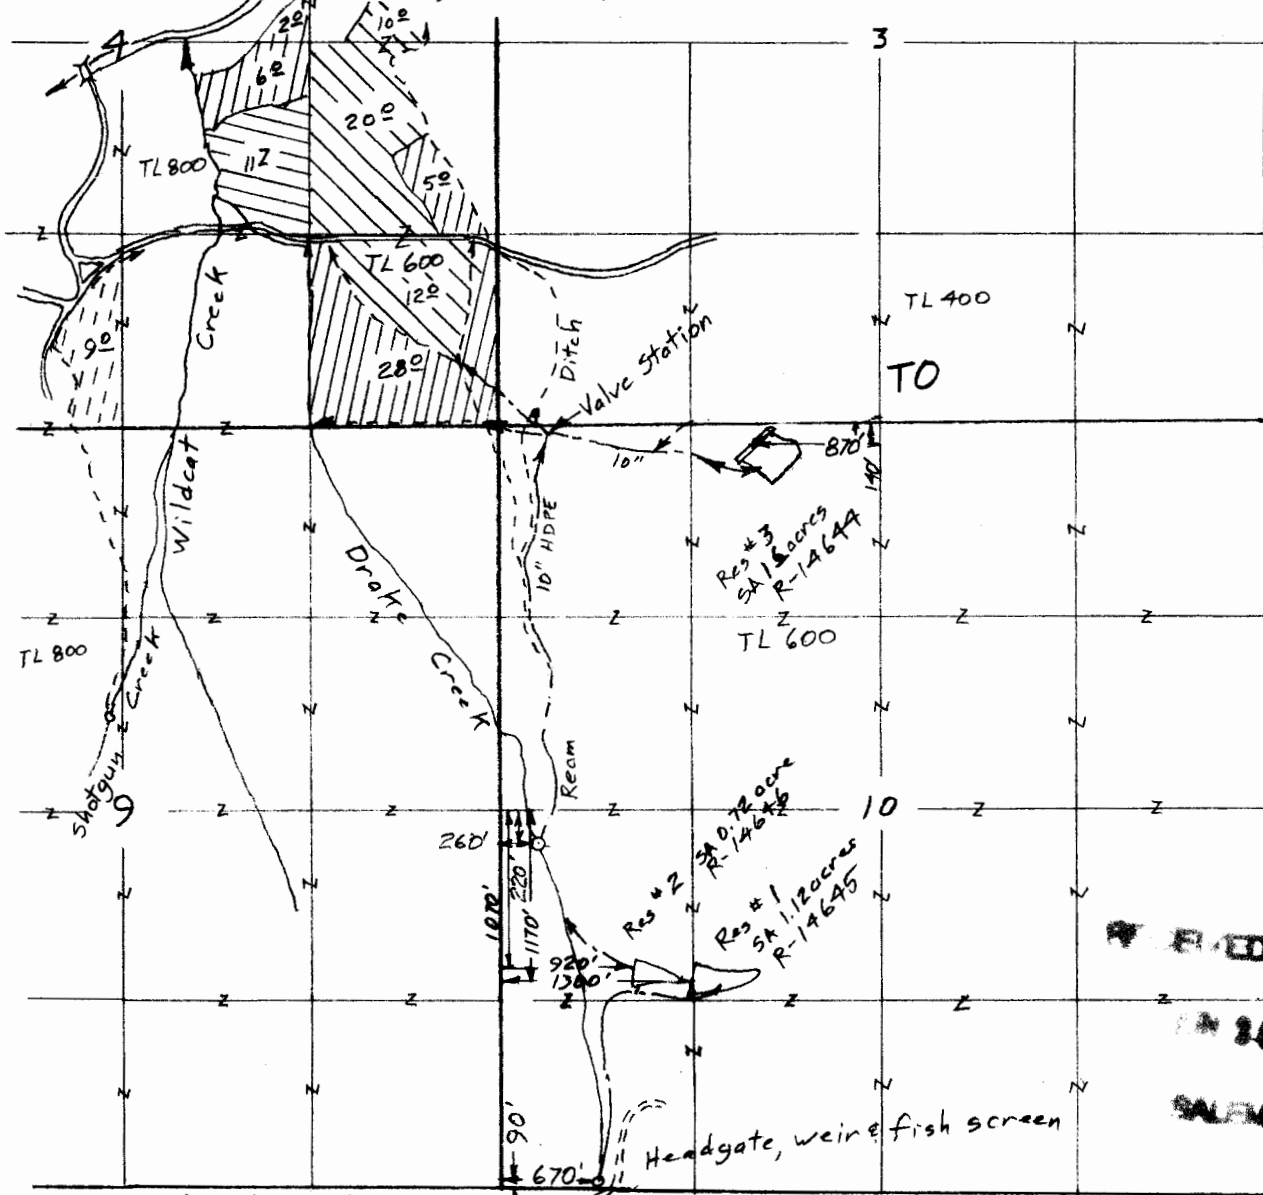

Scale  
1" = 1320'  
(4" = 1 mile)

Surveyed July 10, 2012


### Claim of Beneficial Use Map for Shotgun Ranch, LLC

3 reservoirs also used as bulge in system for:

- ⊗ C-699 42<sup>±</sup> acres
- ⊗ C-81673 112<sup>±</sup> acres
- ⊗ C-10844 41<sup>±</sup> acres

- #1 App. R-87072 Per. R-14645
- #2 App. R-87073 Per. R-14646
- #3 App. R-87071 Per. R-14644

This map is for the purpose of locating a water right only and has no intent to provide legal dimensions or the location of property lines.

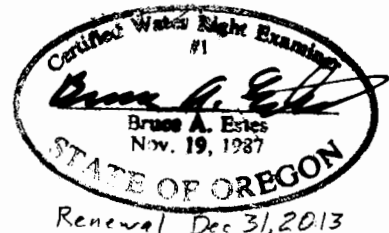

**ESTES SURVEYS, LLC**  
 PO Box 47649  
 Salem, OR 97306-7619  
 (503) 565-7500  
 60332 Arnold Rd  
 Bend, OR 97702  
 (541) 382-7391