










T. 2S. R1E., W.M.

Chris & Kathy Scheller

SECTION 31
CLACKAMAS COUNTY
6061 SW MERIDIAN WAY
TAULATIN, OR. 97062

LEGEND

-  USGS GRID
-  TAXLOT LINE
-  ROADWAY
-  STRUCTURES & DRIVEWAYS
-  2-INCH PVC PIPING WITH RISERS
-  APPROXIMATE C-62489
-  TL-800 P.O.U.
-  ZONED LANDSCAPE SPRINKLERS,
NOT EXCEEDING 14 GPM PER ZONE
-  QUARTER CORNER

PLACE OF IRRIGATION USE WATER USE ACREAGE


SE 1/4 NW 1/4 - 4.18 AC

PREPARATION OF THIS MAP IS FOR THE PURPOSE OF IDENTIFYING THE LOCATION OF THE WATER RIGHT ONLY. THERE IS NO INTENT TO PROVIDE DIMENSIONS OR LOCATION OF PROPERTY OWNERSHIP LINES.

RECEIVED

JAN 30 2015

WATER RESOURCES DEPT
TAULATIN, OREGON

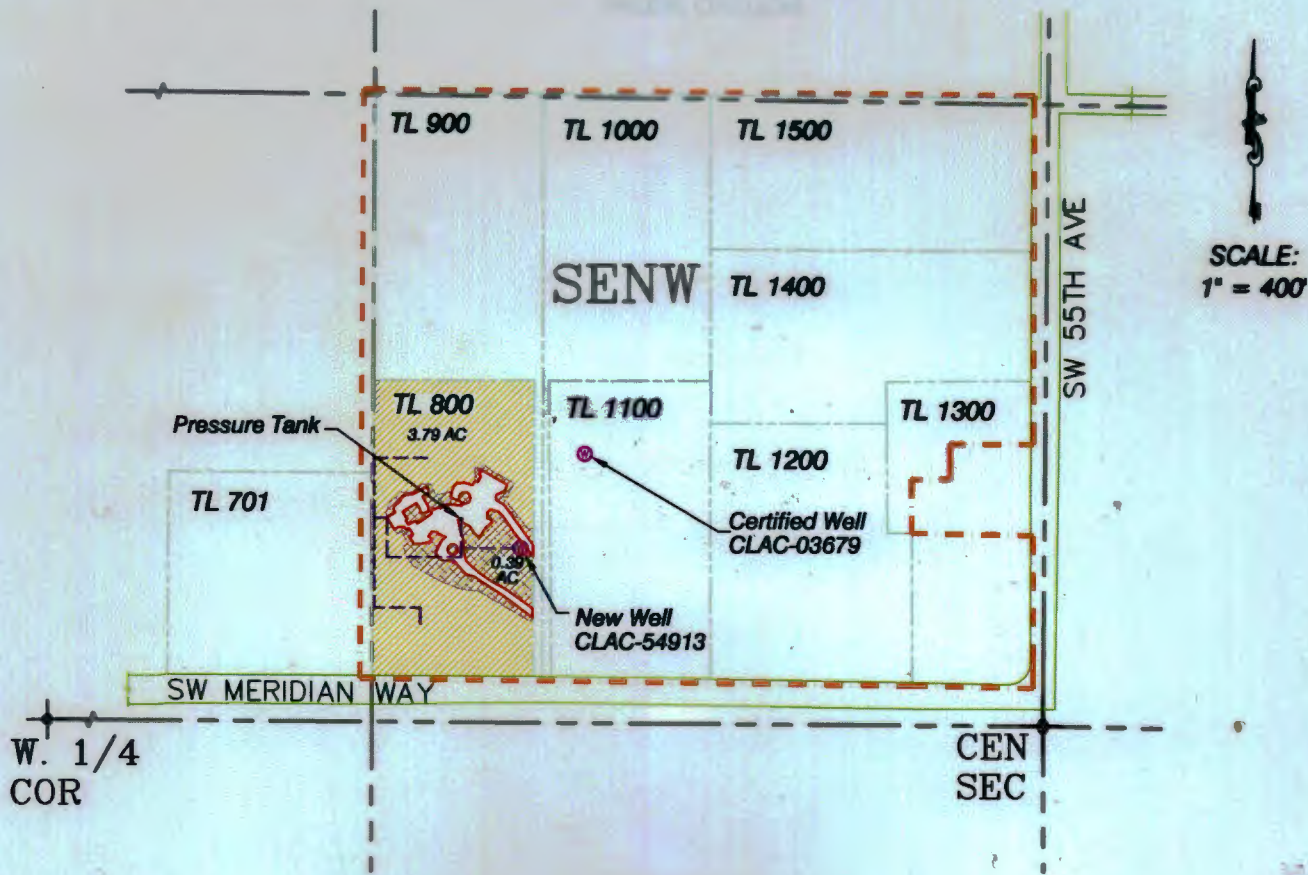


NOTES:

NEW WELL CLAC-54913 IS 352 FEET NORTH AND 1716 FEET EAST FROM THE WEST 1/4 CORNER OF SECTION 31

CERTIFIED WELL CLAC-03679 IS 550 FEET NORTH AND 1850 FEET EAST FROM THE WEST 1/4 CORNER OF SECTION 31

CLAIM OF BENEFICIAL USE MAP

FOR THE ADDITION OF A POA
IN THE NAME OF
CHRIS AND KATHY SCHELLER
FOR
TRANSFER T-11675
SURVEYED DECEMBER 12, 2014
BY JOHN E. BORDEN, CWRE

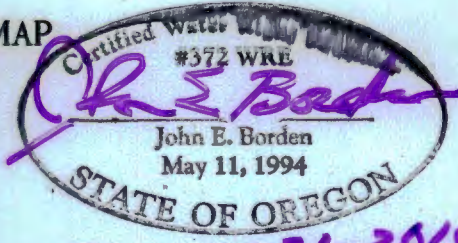

Exp: 12-31-2015

JOHN BORDEN CONSULTING

5597 RIVER STREET
WEST LINN, OR. 97068
503-723-4257

Scheller Claim of Beneficial Use Map

FILE PATH & NAME: X:\SCHELLER\SCHELLER COBU 122414.DWG