



T.9S. R.3 & 4W. W.M.

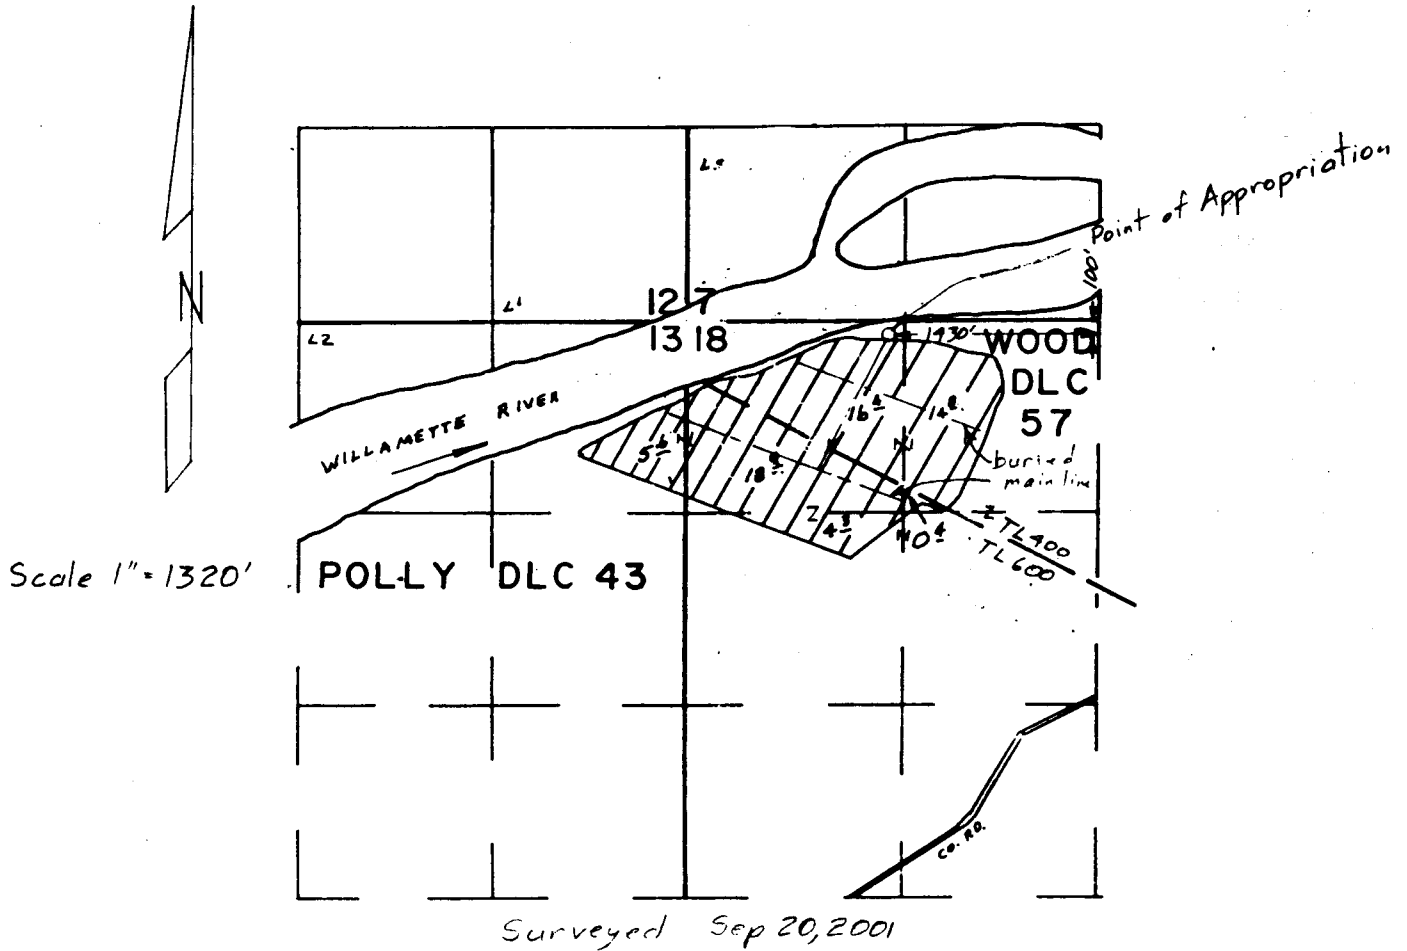

Claim of Beneficial Use Map
for
CHARLES & ANDY KEESECKER

T-8245

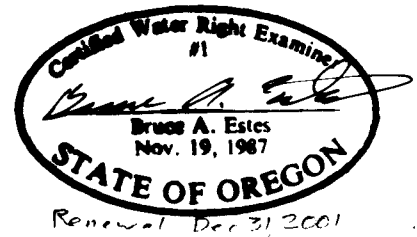

This map is for the purpose of locating a water right only and has no intent to provide legal dimensions or the location of property lines.

ESTES SURVEYS, LLC

6293 Sunnyview Rd. NE 60382 Arnold Rd.
Salem, OR 97306 Bend, OR 97702
(503) 585-7593 (503) 382-7391