

Final Claim of Beneficial Use and Site Report
BLOUNT, INC.
Oregon Cutting System Division
4909. SE International Way
Milwaukie, OR 97222
PERMIT 52963


Page
2

NE 1/4, SW 1/4, Sec 31
0.5 acres irrigated



Irrigated Areas

Scale 1" = 200'

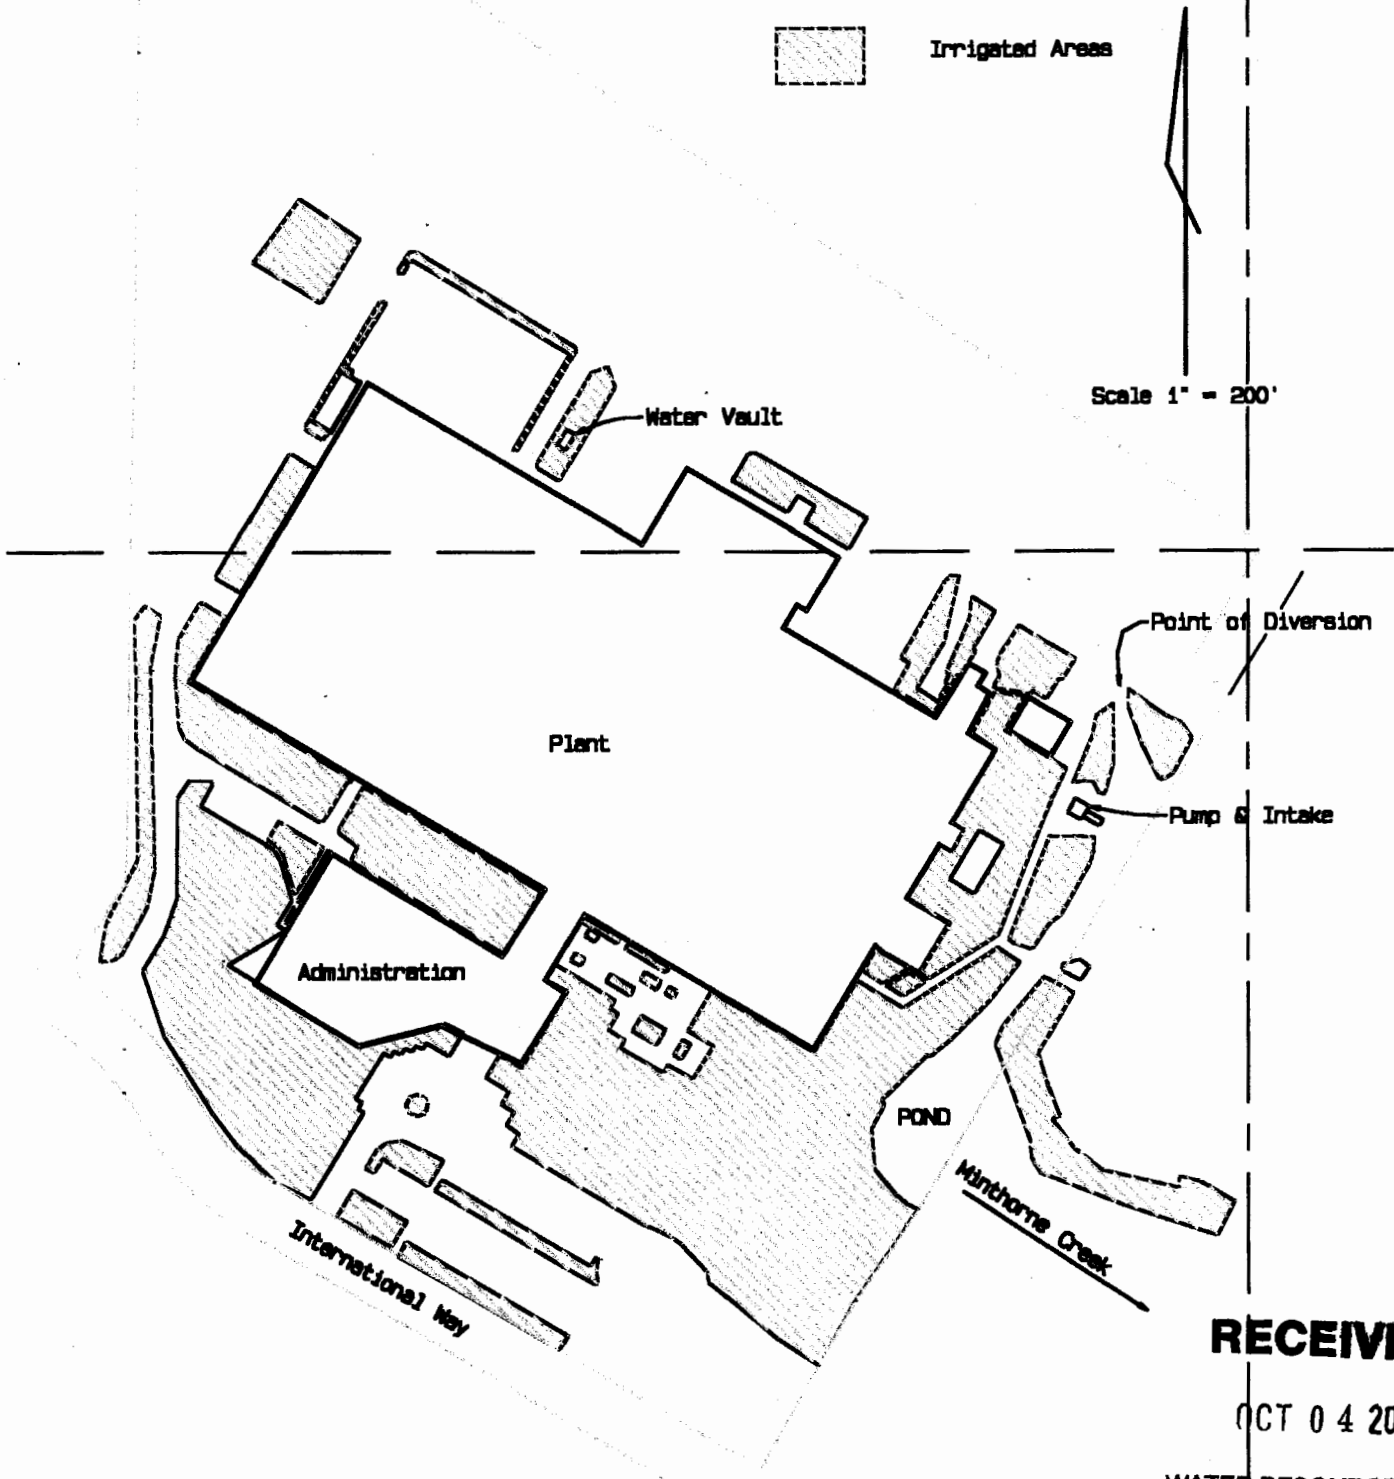

SE 1/4, SW 1/4, Sec 31
6.0 acres irrigated

Township 1 South, Range 2 East, Willamette Meridian

RECEIVED

OCT 04 2000

WATER RESOURCES DEPT.
SALEM, OREGON