


# CLAIM OF BENEFICIAL USE MAP

UNDER APPLICATION R-67830 ; PERMIT R-11794

GOV'T LOT 2 (NW1/4 NE1/4) SEC 4 T 28S R 43E W.M.

U.S.G.S. QUAD - JORDAN CRATERS NORTH, OREG.- 7 1/2'

**RECEIVED**

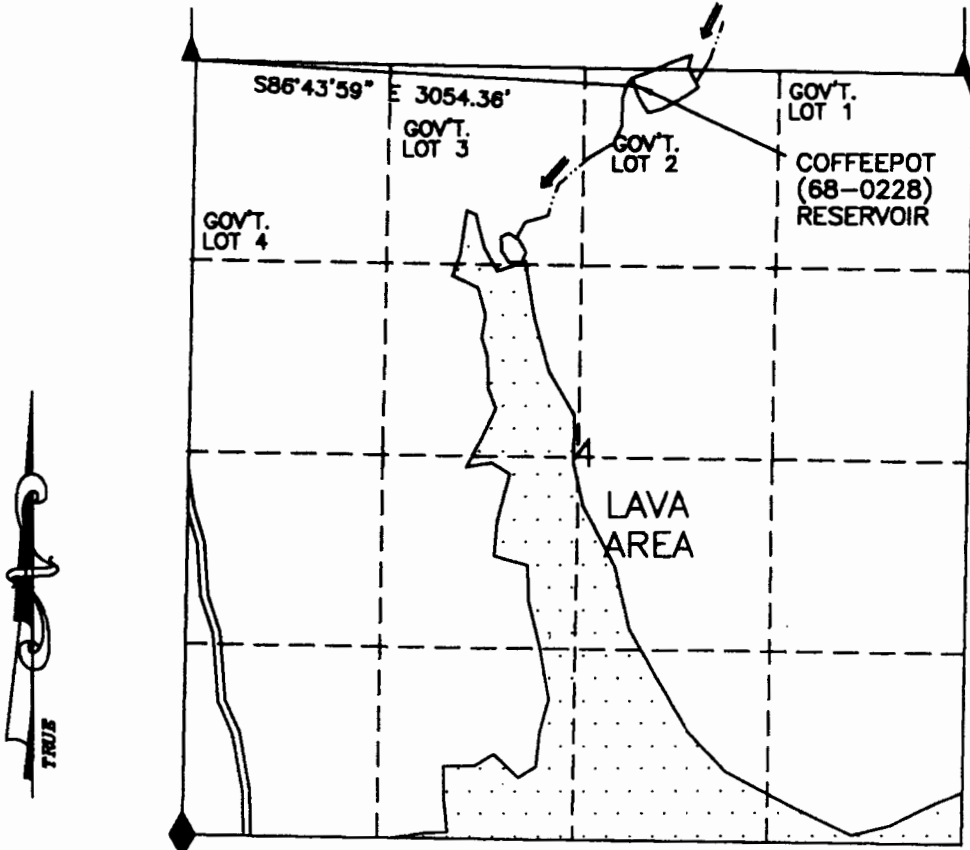


## LEGEND

- SECTION LINE
- 40 ACRE LINE
- CHANNEL
- ROAD
- RESERVOIR
- FD SEC. COR.
- LAVA AREA

PROJECT MON.:  
LAT 43°09'46.113"  
LONG 117°27'27.336"

BASIS OF BEARING SOLAR OBSERVATION

COFFEEPOT (68-0228) RESERVOIR

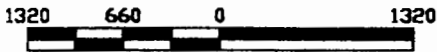

SCALE 1"=1320'

I, Gayla M. Ernst, Acting ADM Operations/Field Services agree to the findings of the CWRE and do submit this site report and map as my Claim of Beneficial Use of the water as provided under the terms and conditions of my Permit R-11794.

*Gayla M. Ernst*



THIS MAP IS FOR THE PURPOSE OF LOCATING A WATER RIGHT AND IS NOT INTENDED TO PROVIDE LEGAL DIMENSIONS FOR LOCATION OF PROPERTY BOUNDARIES.

ACAD14/SDSK80  
DWG FILE:COFFEEDENE

|   |                 |
|---|-----------------|
| UNITED STATES DEPARTMENT OF THE INTERIOR<br>BUREAU OF LAND MANAGEMENT<br>DIVISION OF OPERATIONS VALE DISTRICT |                 |
| COFFEEPOT<br>(68-0228) RESERVOIR  |                 |
| DRAWN BY: _____   |                 |
| SURVEYED: _____   |                 |
| APPROVED: <i>Gayla M. Ernst</i><br>ADM OPERATIONS AND FIELD SERVICES  |                 |
| DRAWN: <i>EG</i>  | SCALE: 1"=1320' |
| DATE: 08/03/2000  | SHEET 1 OF 1    |
| DRAWING NO. OR-03-9172.45-1046  |                 |