


T. 11 S., R 26 E., W. M.

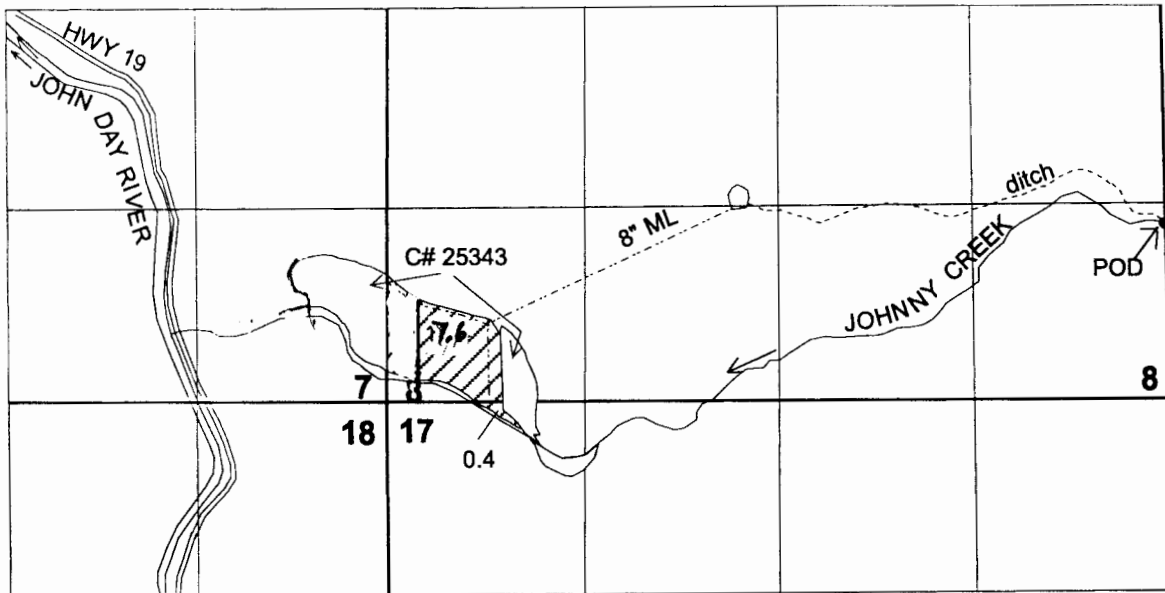

POD - 2530 FEET NORTH AND 27 FEET WEST FROM THE SOUTHEAST CORNER OF SECTION 8.

1200
JC/WRD

FINAL PROOF SURVEY

UNDER

Application No. 51694 Permit No. 37539

IN THE NAME OF

JIM KELLY AND SUE PORTER

Surveyed 07-26-2000, by J. Miller



1" = 1320'

REVISED

Acreage adjusted to reflect
only 8.0 acres from Johnny Creek
Revised 1/28/2015 JC/WRD