
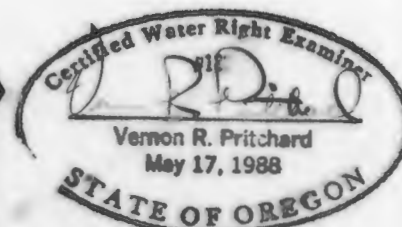


CLAIM OF BENEFICIAL USE MAP

UNDER APPLICATION R-81940; PERMIT R-12251

SW1/4 SE1/4 SEC 32 T 33S R 41E W.M.

U.S.G.S QUAD - THE BASIN, OREG. - 7 1/2'

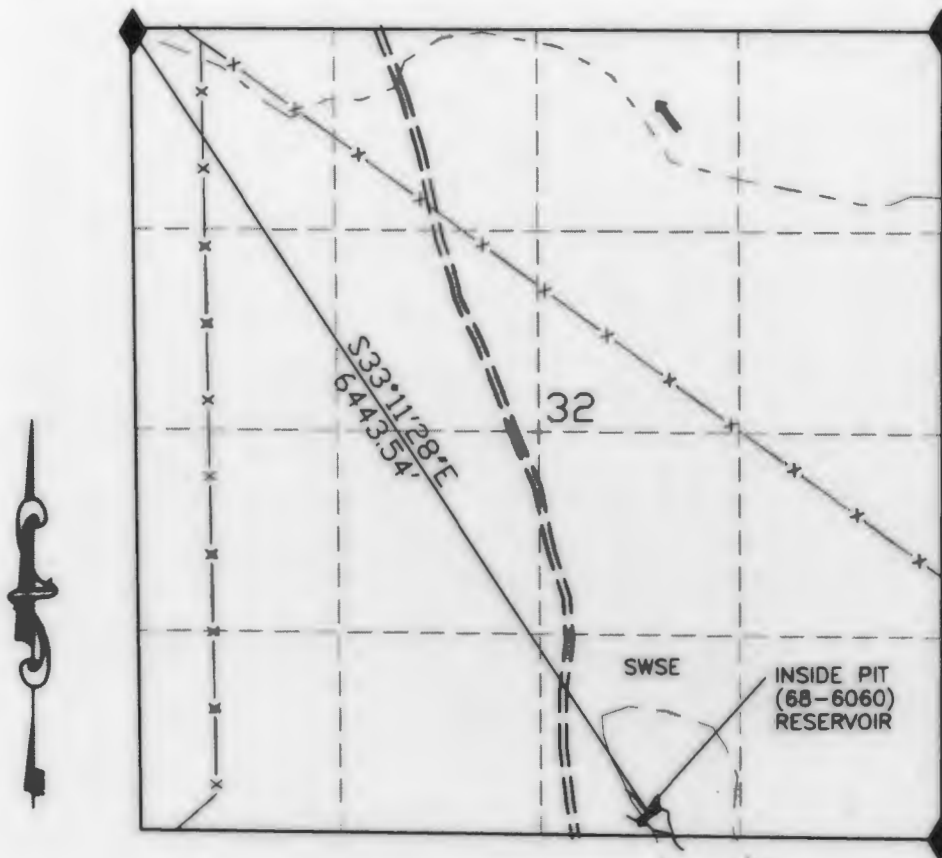

Expires 12/31/02

LEGEND


- RESERVOIR
- ROAD
- CHANNEL
- FD SEC COR
- FENCE
- DRY LAKE BED

RECEIVED

OCT 01 1998

WATER RIGHTS DIV.

INSIDE PIT (68-6060) RESERVOIR

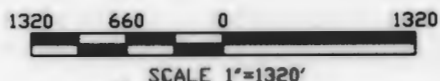

I, James Foster, Acting ADM Operations/Field Services agree to the findings of the CWRE and do submit this site report and map as my Claim of Beneficial Use of the water as provided under the terms and conditions of my Permit R-12251.

James Foster

THIS MAP IS FOR THE PURPOSE OF LOCATING A WATER RIGHT AND IS NOT INTENDED TO PROVIDE LEGAL DIMENSIONS FOR LOCATION OF PROPERTY BOUNDARIES.



ACAD14/SDSK8.0
DWG FILE: INSIDEBEN.DWG

UNITED STATES DEPARTMENT OF THE INTERIOR BUREAU OF LAND MANAGEMENT DIVISION OF OPERATIONS VALE DISTRICT	
INSIDE PIT (68-6060) RESERVOIR	
DRAWN BY: <u>James R. Pritchard</u>	
SURVEYED: <u>James R. Pritchard</u>	
APPROVED: <u>James Foster</u>	ADM OPERATIONS AND FIELD SERVICES
DRAWN: <u>CG</u>	SCALE: 1\"/>

DATE: 10/18/00 SHEET 1 OF 1
DRAWING NO. OR-03-9172.45-1056