


T. 26 S., R. 27 E., W.M.

DIVERSION IS 1510
FEET SOUTH AND
1445 FEET EAST OF
THE NW CORNER OF
SECTION 13.

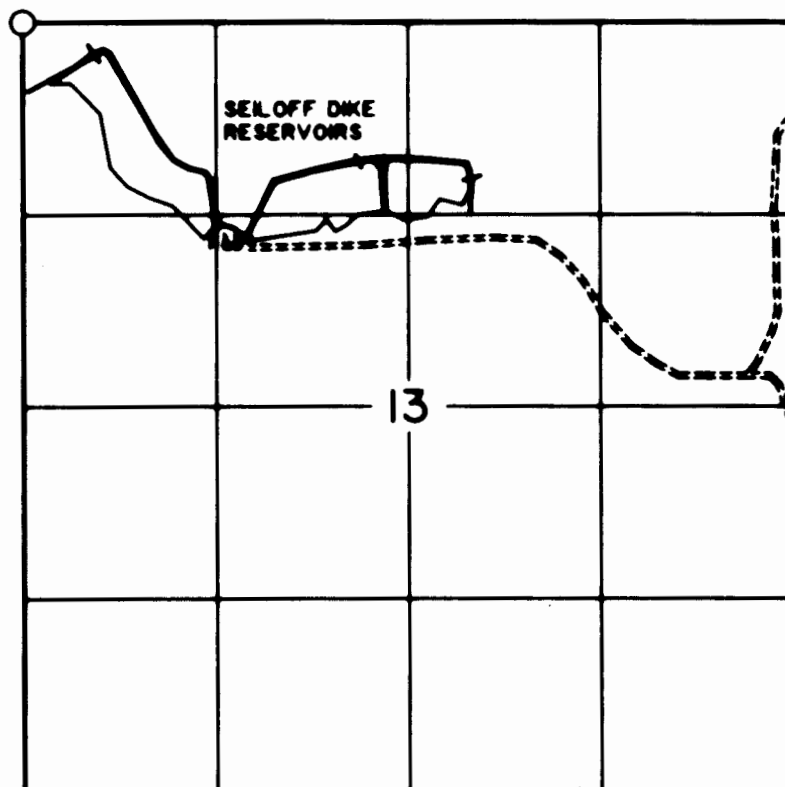

1" = 1320'

CLAIM OF BENEFICIAL USE MAP

IN NAME OF

UNITED STATES BUREAU OF LAND MANAGEMENT

APPLICATION NO. R-66467

PERMIT NO. R-12509


RECEIVED

OCT 02 2000

WATER RESOURCES DEPT.
SALEM, OREGON

SURVEYED: AUGUST 30, 2000

THE PURPOSE OF THIS MAP IS FOR IDENTIFYING THE LOCATION OF THE WATER RIGHT ONLY AND
IS NOT INTENDED TO PROVIDE LEGAL DIMENSIONS OR LOCATION OF PROPERTY OWNERSHIP LINES.

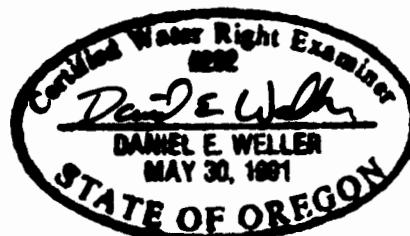

EXPIRES: JUNE 30, 2002

BLM PROJECT NO. OR-5011

U.S. BUREAU OF LAND MANAGEMENT-OSO
BRANCH OF CADASTRAL SURVEY
DWG: SELOFF

EXECUTED BY:
DANIEL E. WELLER, PLS, CWRE
P.O. BOX 2965
PORTLAND, OREGON 97208