

T 13 S, R 31 E, Sec 33

SE 1/4, SW 1/4, TAX LOT 500

Scale 4" = 1 mi


Pond located:

- 700 feet North and
- 1250 feet West from
- the S. 1/4 corner of Sec 33.

RECEIVED JOHN DAY
STATE AIRPORT

OCT 08 1999

WATER RESOURCES DEPT.
SALEM, OREGON

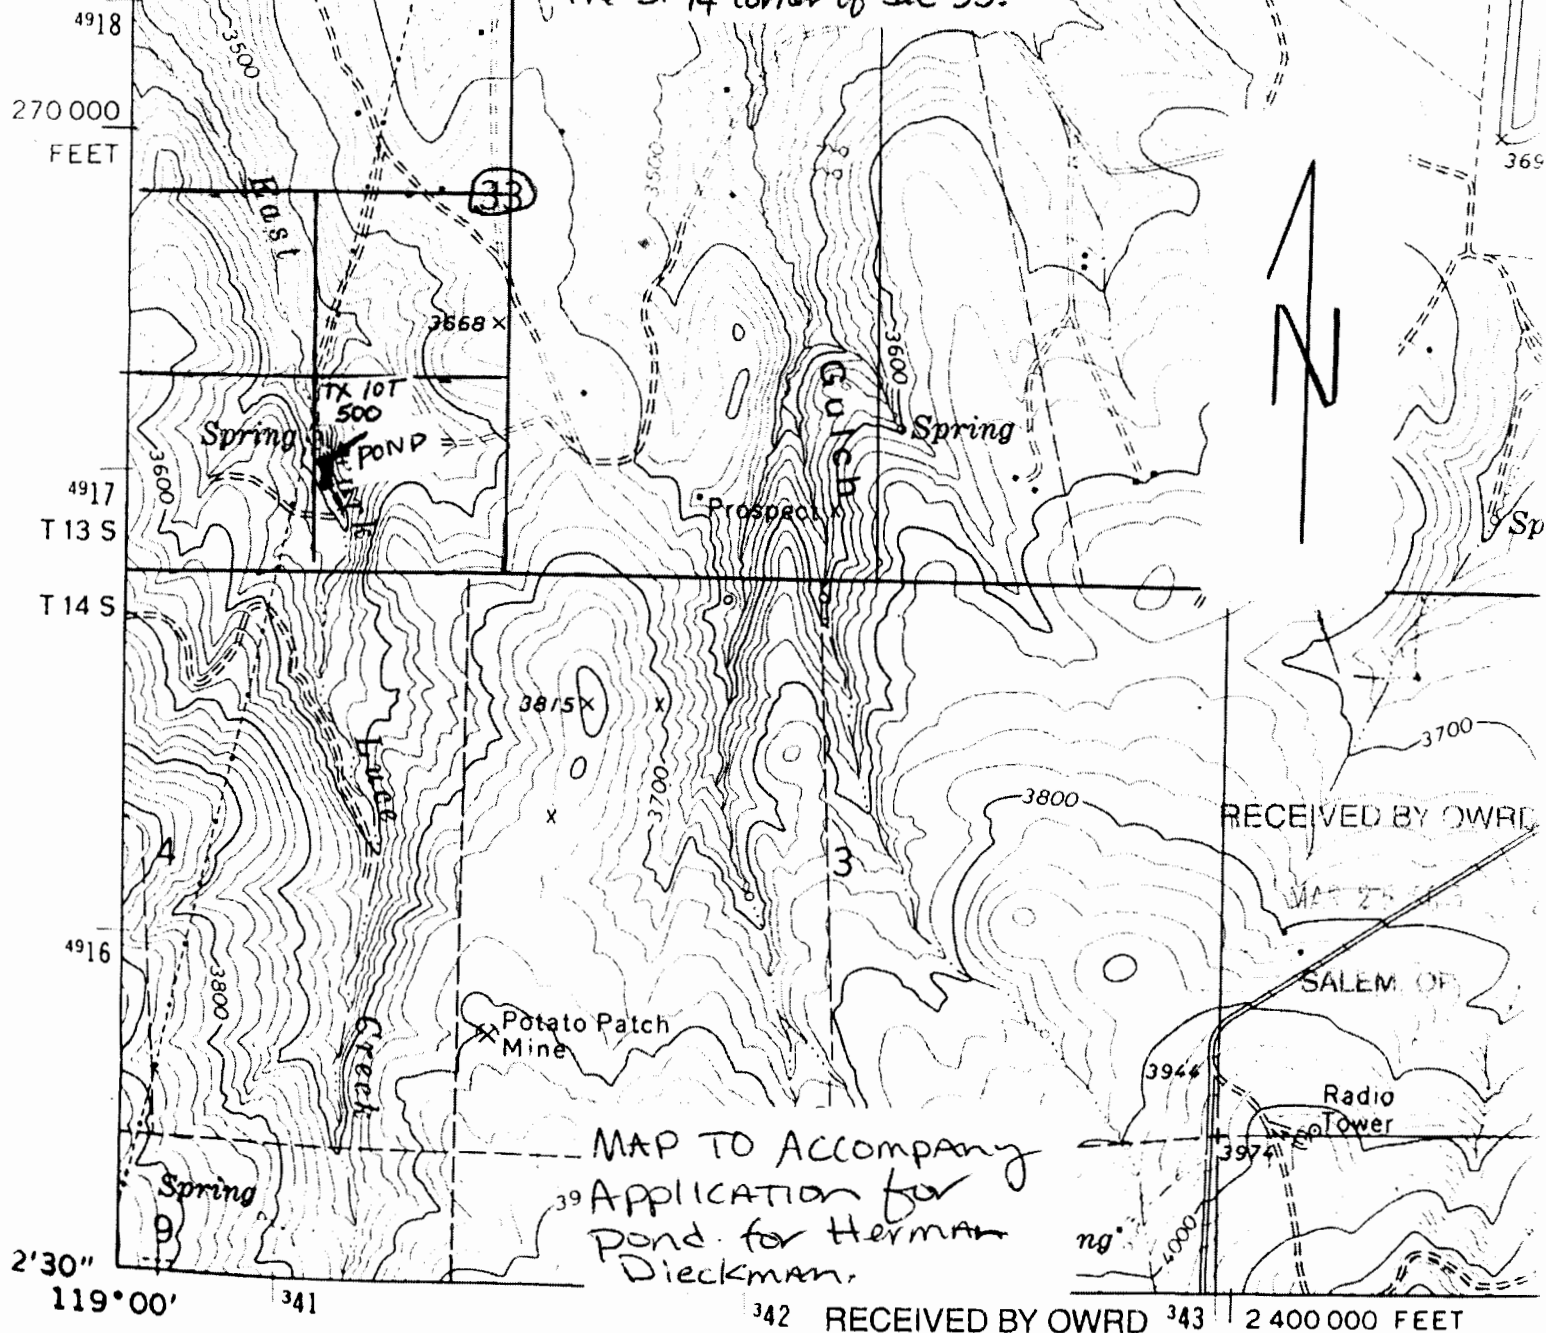

RECEIVED BY OWRD

MAY 24 1999

SALEM, OR

Radio
Tower

MAP TO Accompany
Application for
Pond for Herman
Dieckman.

RECEIVED BY OWRD 2400000 FEET

Mapped, edited, and published by the Geological Survey
Control by USGS and NOS/NOAA

Topography by photogrammetric methods from aerial
photographs taken 1971. Field checked 1972

and 10,000-foot grid ticks: Oregon coordinate
zone (Lambert conformal conic)

Universal Transverse Mercator grid ticks,
shown in blue 1927 North American datum

John Day 7 1/2 min
Quad enlarged
152% = 4" = 1 mi

No. 84278

No. R-12856

1°21'
24 MILS

18 1/2°
329 MILS