


PERMIT NUMBER 53749
T 23 S R 12 W
SW 1/4 SW 1/4 SEC. 16
COOS COUNTY, OREGON
SCALE 1" = 200 FT.

PREPARED FOR
JAMES & BRIGITTE GASTREICH
4316 S TEN MILE LAKE
LAKEVIEW, OREGON 97449

NOTE: THE PREPARATION OF THIS
MAP IS FOR THE PURPOSE OF
IDENTIFYING THE LOCATION OF
THE WATER RIGHT ONLY AND IS
NOT INTENDED TO PROVIDE
DIMENSION OR LOCATION OF
PROPERTY OWNERSHIP LINES.

 


DIVERSION POINT
NORTH 20 FEET
EAST 100 FEET
FROM SOUTHWEST
CORNER OF SEC. 16

FOUND
BRASS CAP

17
16
20' 21'

TEN MILE LAKE

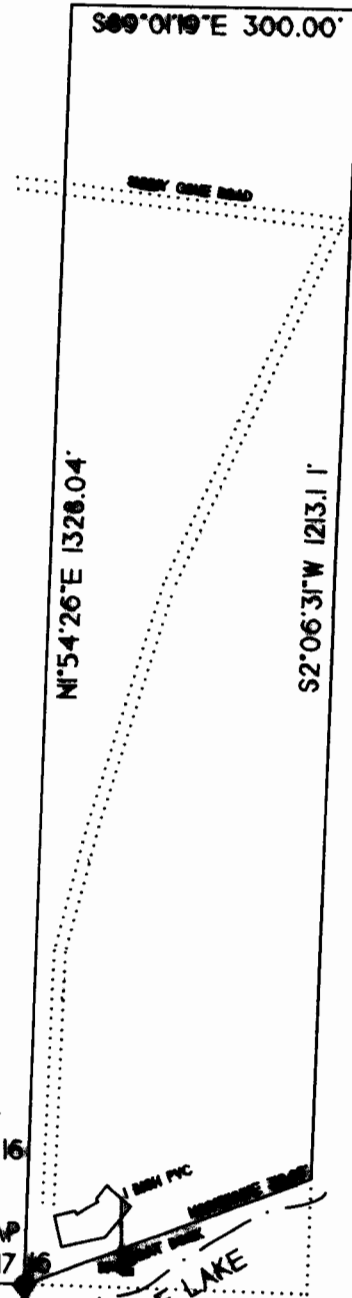

NORTH

FINAL PROOF SURVEY
APRIL 14, 2005

RECEIVED

MAY 10 2005

WATER DIVISION
SPECIAL AGENT