

Township 23 South, Range 12 West,
Willamette Meridian

RECEIVED


JUL 14 2005
WATER RESOURCES DEPT
SALEM, OREGON



1/16 CORNER

SCALE
1"=400'

BLACKS ARM
NORTH TENMILE LAKE

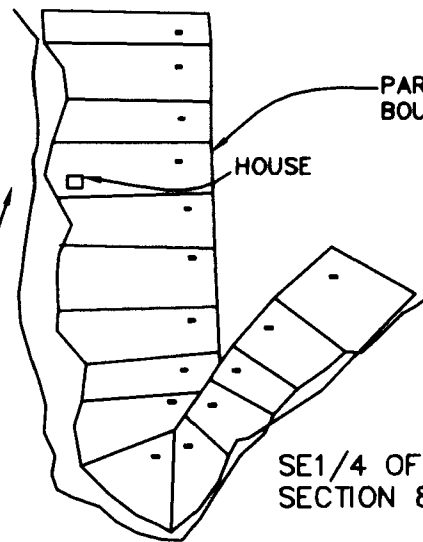

SE 1/4 OF THE NE 1/4,
SECTION 8


1/4 CORNER

POINT OF DIVERSION
LOCATED SOUTH 8 DEGREES 36 MINUTES
WEST A DISTANCE OF 900 FEET, THEN
NORTH 0 DEGREES 5 MINUTES EAST A
DISTANCE OF 1065 FEET FROM THE SE
1/4 OF THE NE 1/4 QUARTER CORNER
SECTION 8, T.23S., R.12W. W.M.

FINAL PROOF SURVEY

under
Application Number S-85760, Permit Number S-54060

APRIL 28, 2005

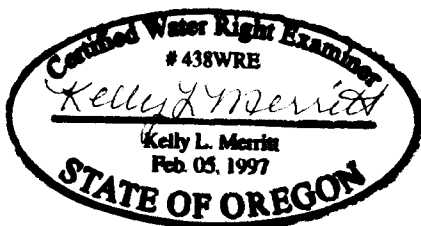

THIS MAP WAS PREPARED FOR THE PURPOSE
OF IDENTIFYING THE LOCATION OF A WATER
RIGHT ONLY AND IS NOT INTENDED TO
PROVIDE LEGAL DIMENSIONS OR LOCATION OF
PROPERTY OWNERSHIP LINES.