





Sections 11 & 12, T5S, R2W, W.M.,
Marion County, Oregon

Application G-14934, Permit G-13768
CLAIM OF BENEFICIAL USE MAP
WinCo Foods, Inc.

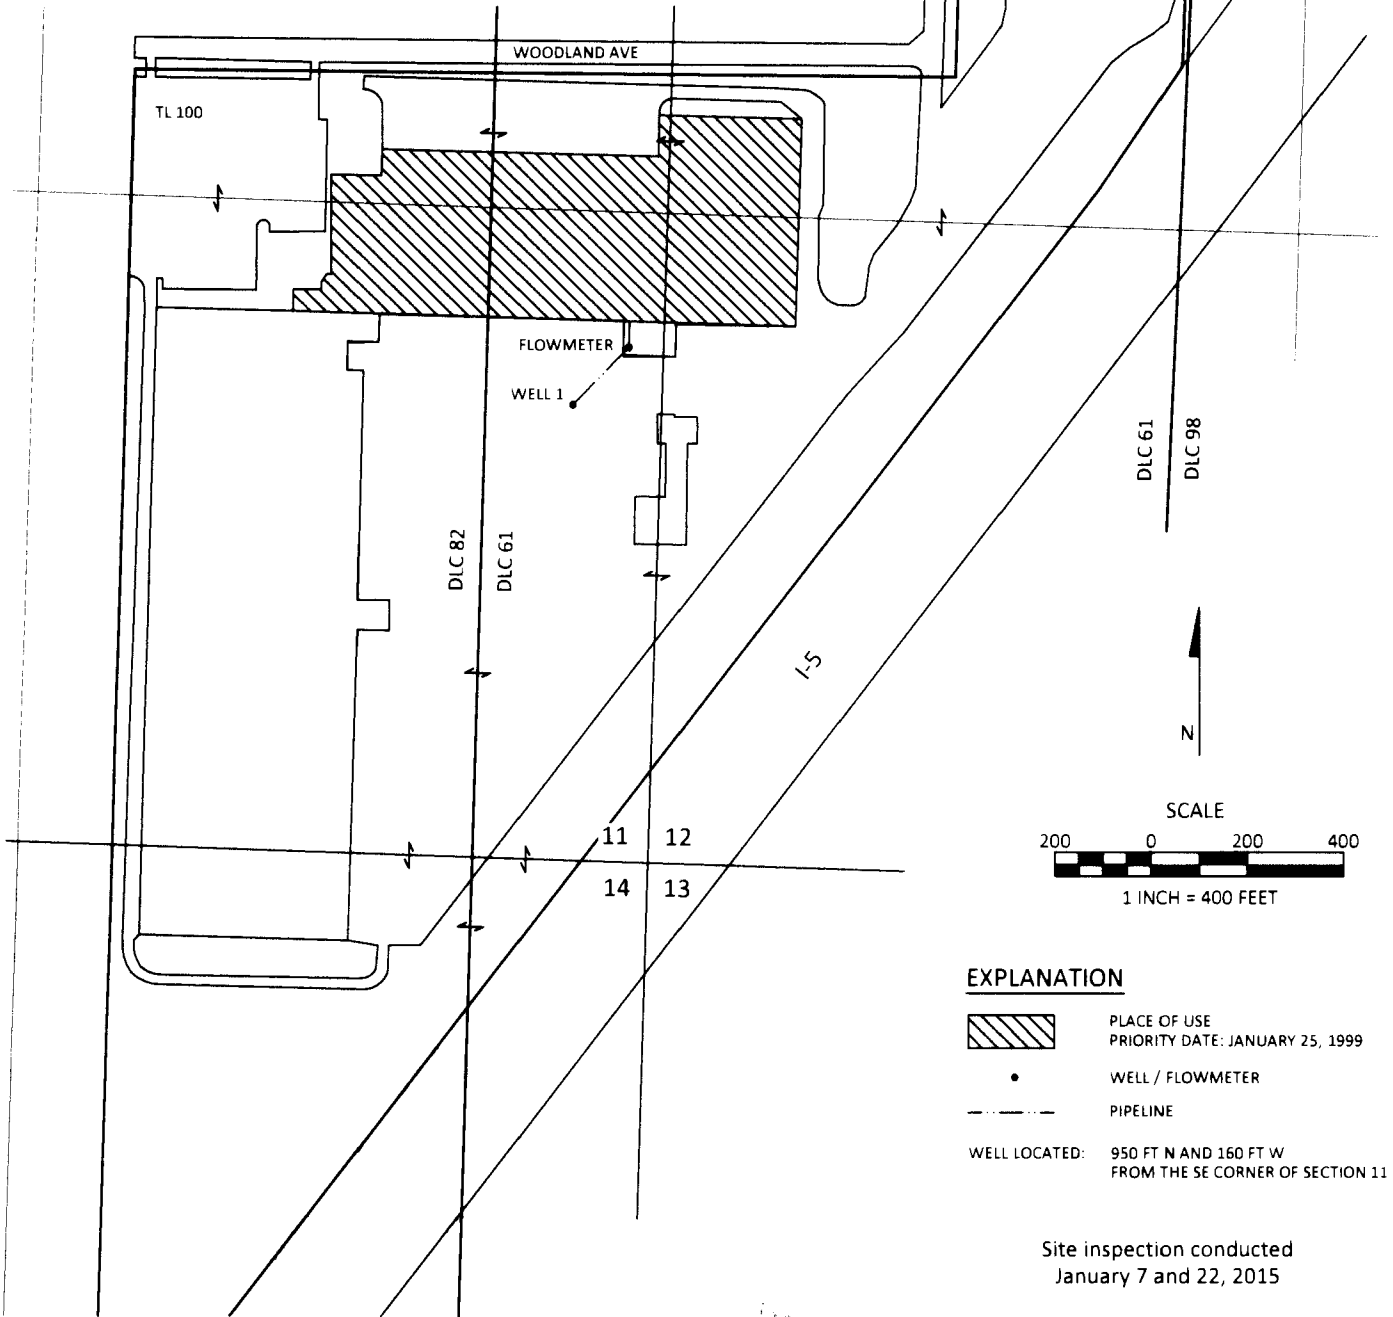

EXPLANATION

-  PLACE OF USE
PRIORITY DATE: JANUARY 25, 1999
 -  WELL / FLOWMETER
 -  PIPELINE
- WELL LOCATED: 950 FT N AND 160 FT W
FROM THE SE CORNER OF SECTION 11

Site inspection conducted
January 7 and 22, 2015

January 23, 2015

This map is not intended to provide legal
dimensions or locations of property
ownership lines

Figure 1

SKOOGKUM

P.O. BOX 80174
PORTLAND, OR 97280
(503) 319-8926

