


T. 37S.R. 4 & 5 W.W.M.

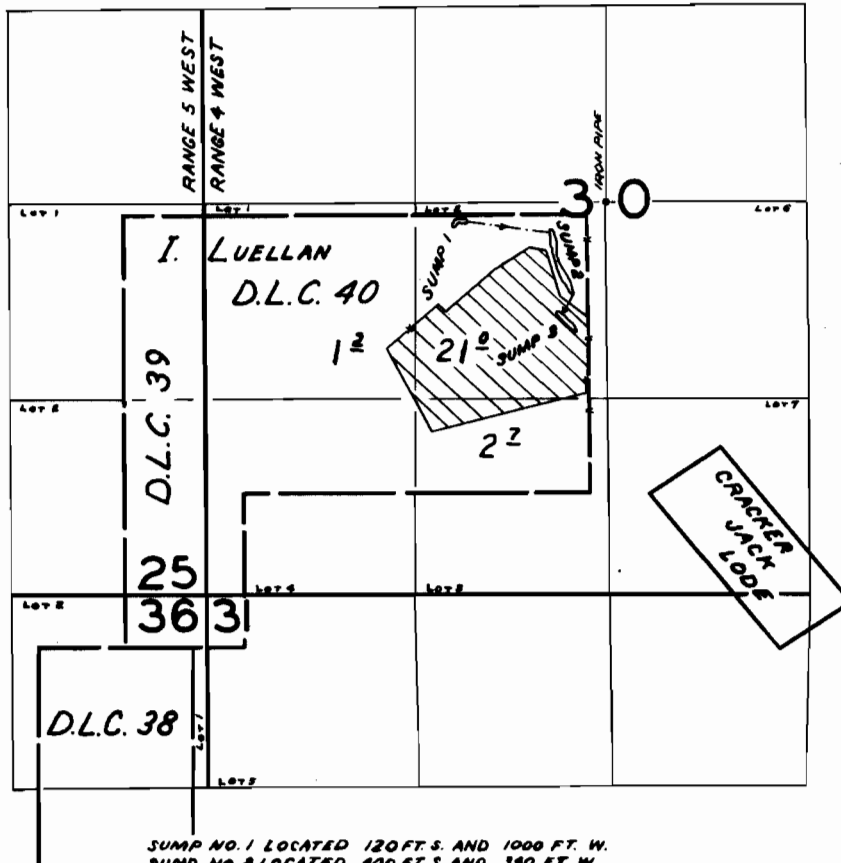

SUMP NO. 1 LOCATED 120 FT. S. AND 1000 FT. W.
SUMP NO. 2 LOCATED 400 FT. S AND 390 FT. W.
SUMP NO. 3 LOCATED 810 FT. S AND 270 FT W.
ALL FROM THE CENTER OF SEC. 30.

FINAL PROOF SURVEY
UNDER

Application No. G-2245 Permit No. G-2067

IN NAME OF

HARRY R. ALBERTY

Surveyed JUN. 28 1985, by C. GARDNER

Transfer of water rights

Certificate 34036




Township 37 South, Range 4 West, Sec 30, W.M.

Page 1 of 2
August 7, 2002

Note: This map denotes the activity of transfer relating to Certificate 34036. Refer to the map for transfer of Certificate 62338 also.

Well # 1
120 ft South
1000 ft West
From the Center of Sec 30

Well # 2
400 ft South
340 ft West
From the Center of Sec 30

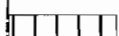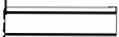-  Primary right transfer from
-  Primary right transfer to
-  No change

NW SW


Note: Map prepared for water right purposes only. Not for boundary locations.

RECEIVED

SEP 19 2002

WATER RESOURCES DEPT.
SALEM, OREGON

SW SW

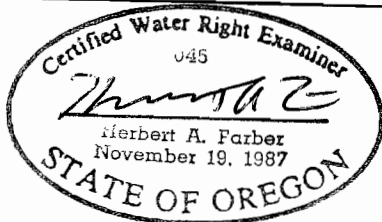

RENEWAL DATE 12-31-2003



Scale 1" = 400'

Tax lot 37-4W-30-303

SE SW

Well # 3
810 ft South
270 ft West
from the Center of Sec 30

Prepared by
Farber & Sons Inc
Farber Surveying
120 Mistletoe St
Medfore, Oregon 97501
541-776-0846
Drawn by
Hollie Cannon

Range 5 West
Range 4 West

25 30
36 31

T-9253