
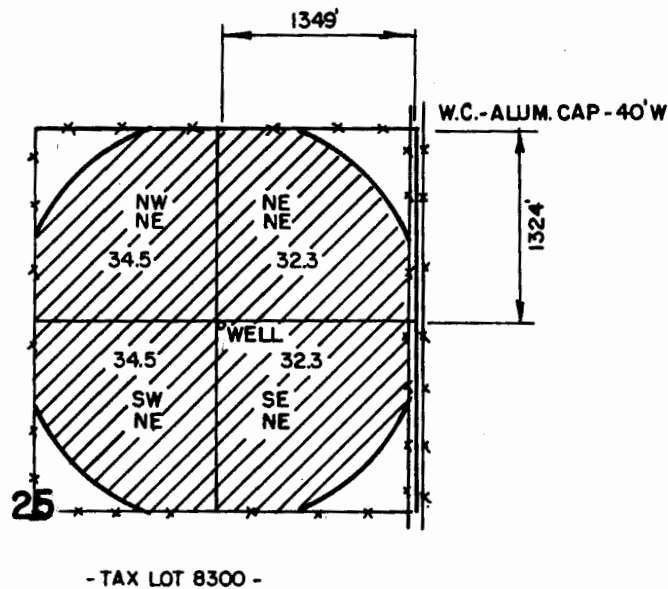


T 25 S, R 33 E, WM

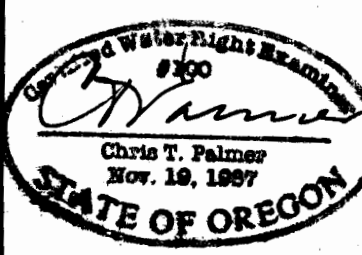

THE PURPOSE OF THIS MAP IS TO IDENTIFY THE LOCATION OF THE WATER RIGHT IT IS NOT INTENDED TO PROVIDE INFORMATION RELATIVE TO THE LOCATION OF PROPERTY OWNERSHIP.

RECEIVED
AUG 26 2005
WATER RESOURCES DEPT
SALEM, OREGON

 Chris T. Palmer Nov. 19, 1997 RENEW 1-1-2007	FINAL PROOF SURVEY		IN THE NAME OF GORDON PECK	
	UNDER APPLICATION G-15256 PERMIT G-15206			
	Scale: 4 = 1 MILE	Date: JUNE 2005	Job: 1657A-05	
	Den:	Drn: CHRIS	Ckd:	Sht. No.
M.A.P.'s		M. A. PALMER & SONS, INC. ENGINEERING & SURVEYING 254 N. Alder - Box 61 Burns, Oregon 97720		of 1