



CLAIM OF BENEFICIAL USE MAP UNDER PERMIT R-11840
 T. 40 S., R. 9 W., W. M., JOSEPHINE COUNTY

Section 25, S1/2 NE1/4

May 31, 2008

N
 ↑
 1" = 400'

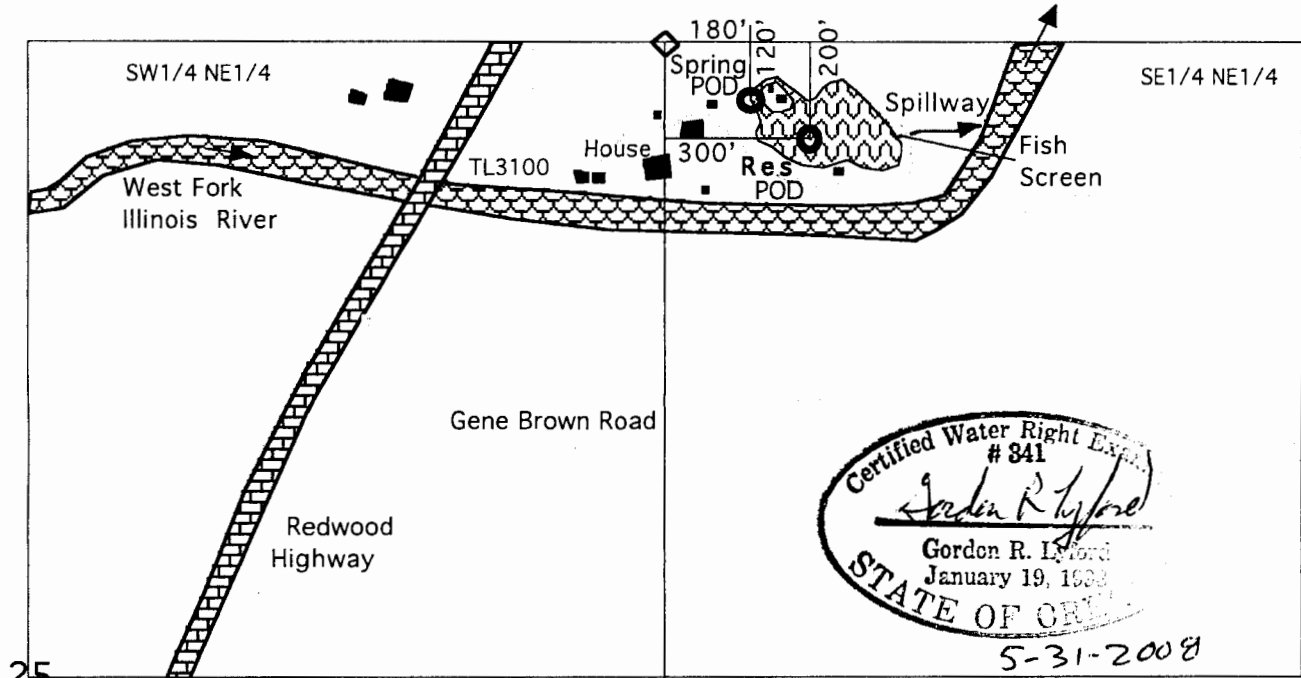

 Unnamed reservoir constructed under Application R-70668 and Permit R-11840 with a priority of September 17, 1990 to store the waters of an unnamed spring for fish culture uses under Application S-70667 and Permit S-52312.

 PODs for an unnamed spring and an unnamed reservoir.

 Dirt roads

 Buildings

RECEIVED

JUN 06 2008

**WATER RESOURCES DEPT
 SALEM, OREGON**

This map was drawn by Gordon R. Lyford for Shalwa L. Nicolaw to support her Claim of Beneficial Use to store water in an unnamed reservoir from an unnamed spring for fish culture uses. Shalwa L. Nicolaw owns tax lot 3100.

This map was prepared for the purpose of identifying the location of water rights only and is not intended to provide legal dimensions or the location of property ownership lines.