

**Black Bull Spring Ranch**

2335 Crowley Riverside Road (P.O. Box 222)

Arock, Oregon

(541)586-3099


Malheur County, Oregon

**Daniel J. Hutchison**

Cell Phone (208)830-7429

Owyhee River Basin  
**Water Rights Application Map**  
Malheur County Tax Lot 1900

(Section Corner common to 26/27/34/35)

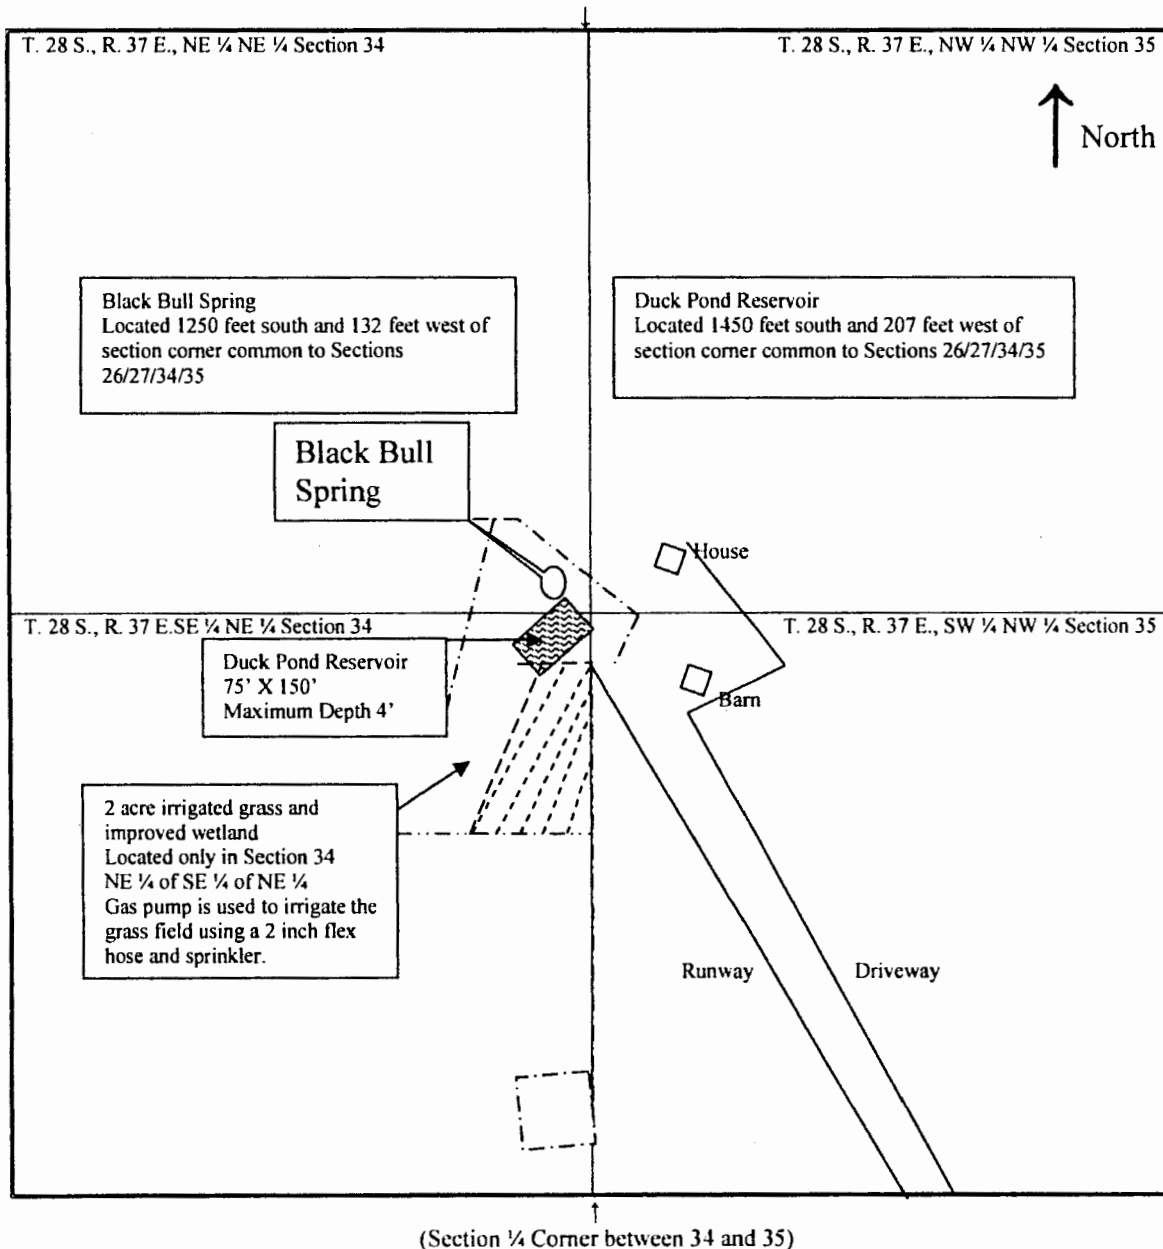

1" = 440 feet 6" = 1/2 mile. Pasture Fencing: - - - - -

Township 28 South, Range 37 East, Section 34 E 1/2 NE 1/4 and Section 35 W 1/2 NW 1/4.

Malheur County Tax Lot # 1900.

May 16, 2013

RECEIVED BY OWRD

MAY 20 2013

SALEM, OR