


FINAL PROOF SURVEY FOR DAVID SHEETS
LOCATED IN THE SE1/4 OF SECTION 33,
T.12S., R.15E., W.M., JEFFERSON COUNTY,
OREGON W.O. 13-4352
APPLICATION R-87790
PERMIT R-14978

PREPARED FOR

DAVID SHEETS
10910 SE GRIZZLY ROAD
MADRAS, OR 97741
(541) 639-5156

PREPARED BY

ARMSTRONG SURVEYING
& ENGINEERING, INC.
267 NE SECOND ST. STE. 100
PRINEVILLE, OR 97754
(541) 447-7791

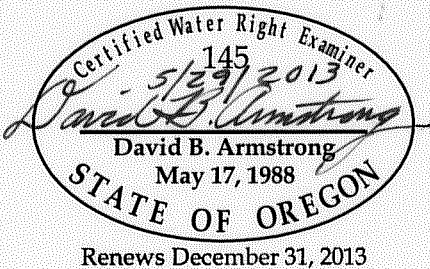

LEGEND

- RESERVOIR DAM
- ① RESERVOIR OUTLET
- DRAINAGE



RESERVOIR LOCATION

- ① LOCATED 1130 FEET NORTH AND 840 FEET WEST OF S.E. CORNER OF SECTION 33. N44°28'46.1" W120°55'52.3" POND SURFACE AREA=0.82 ACRES

NOTE

THE PREPARATION OF THIS MAP IS FOR THE PURPOSE OF IDENTIFYING THE LOCATION OF THE WATER RIGHT ONLY AND HAS NO INTENT TO PROVIDE DIMENSIONS OR LOCATIONS OF PROPERTY OWNERSHIP LINES.

RECEIVED BY CWRD
JUN 11 2013
SALEM, OR

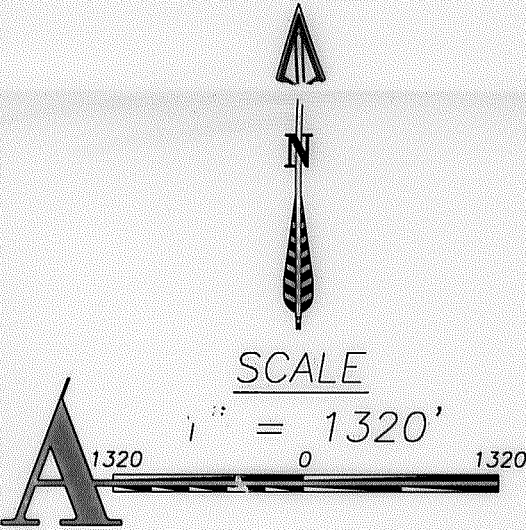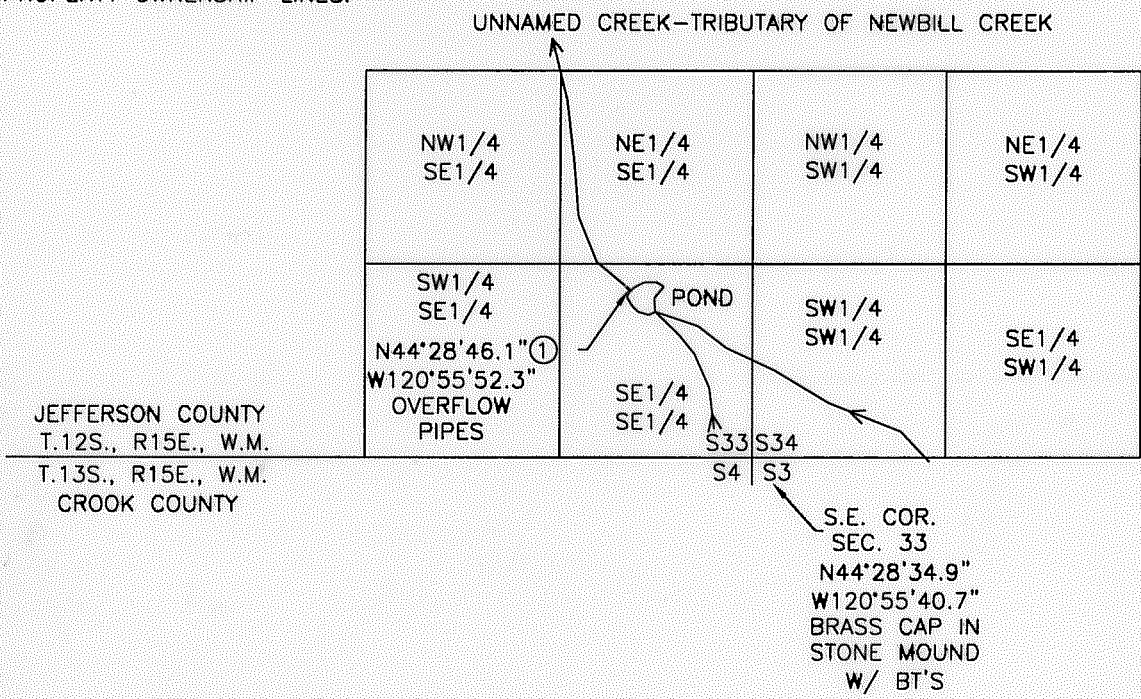

MAY 16, 2013

ARMSTRONG
surveying & engineering, inc.
established 1977
SHEET 1 OF 1
DRG. NO. 13-4352.DWG
W.O. 13-4352