


N

T 25 S, R 31 E, WM

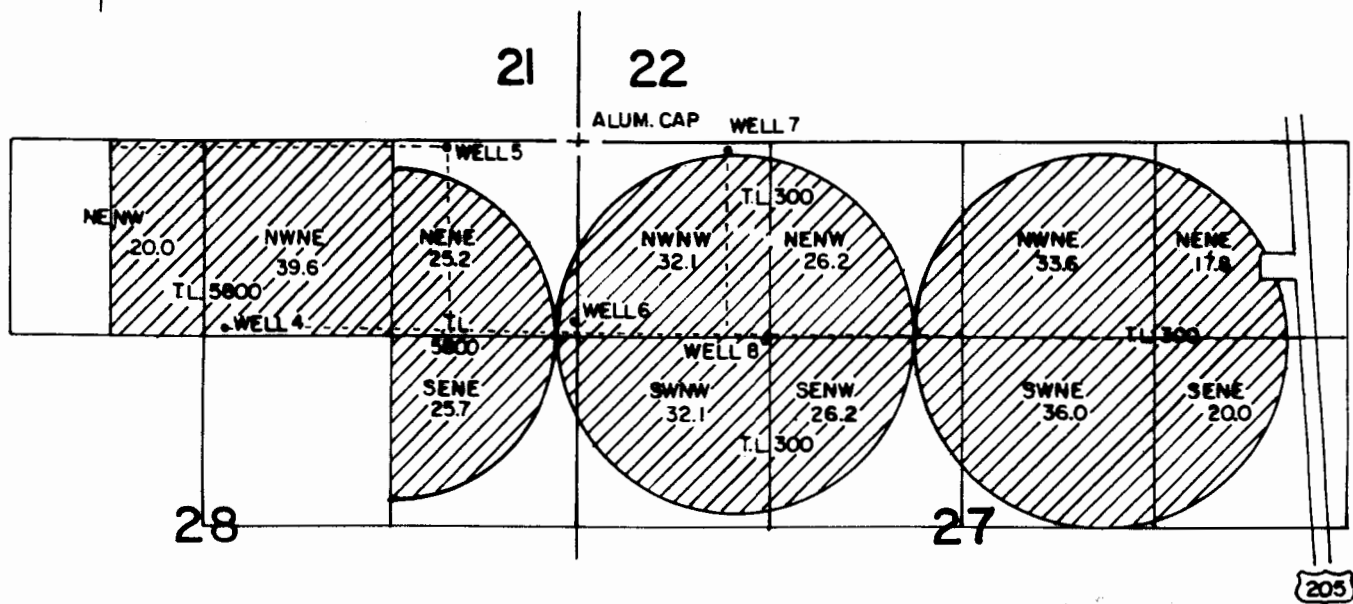

THE PURPOSE OF THIS MAP IS TO IDENTIFY THE LOCATION OF THE WATER RIGHT. IT IS NOT INTENDED TO PROVIDE INFORMATION RELATIVE TO THE LOCATION OF PROPERTY OWNERSHIP.


WELL LOCATIONS FROM THE CORNER COMMON TO SECTIONS 21, 22, 27, 28

- WELL 4 1295'S 2504'W
- WELL 5 64'S 985'W
- WELL 6 1271'S 2'W
- WELL 7 51'S 1030'E
- WELL 8 1341'S 1292'E

RECEIVED


AUG 3 2009

WATER RESOURCES DEPT
Smt. 2000, 2000

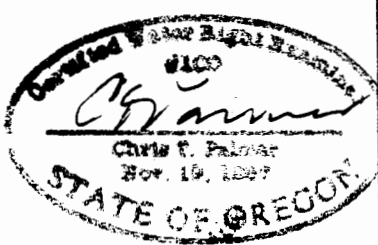

RENEW 1-1-2011

FINAL PROOF SURVEY

UNDER T-10323 & 10324		IN THE NAME OF BEVERLY SAUCY	
Scale: 4" = 1 MILE	Date: AUG. 2009	Job: 2285-09	
Dsn:	 M.A. PALMER & SONS, INC. ENGINEERING & SURVEYING 711 Ponderosa Village • Box 61 Burns, Oregon 97720	Sht. No.	
Dm: CHRIS			
Ckd:		of 1	