

T. 6 S. R. 3 W. W.M.

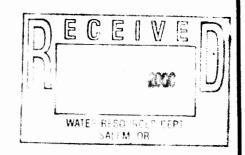

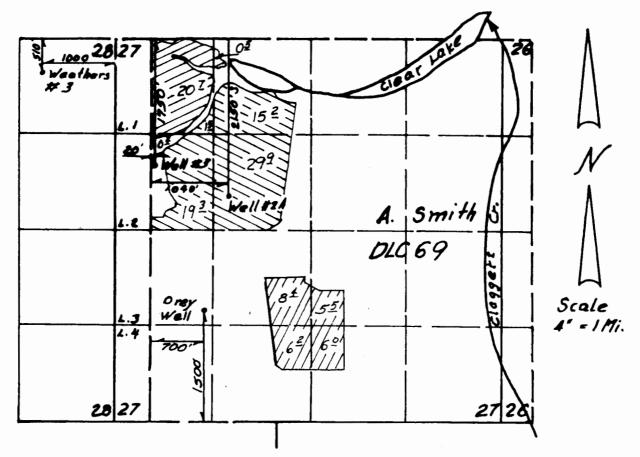

Cert. 35019 Wells 182 Cert. 5793 777777

## **FINAL PROOF SURVEY** UNDER

Transfer No. T-7020

IN NAME OF

.....MILLER FOREST, INC.

Moed Water Right Exam

THIS MAP WAS PREPARED FOR THE PURPOSE OF IDENTIFYING THE LOCA- Surveyed N.G.C. 22., .2000, by ..... TION OF A WATER RIGHT ONLY AND IS NOT INTENDED 19 PROVIDE LEGAL DIMENSIONS OR EXCATION OF PROPER-TY OWNERSHIP LINES.