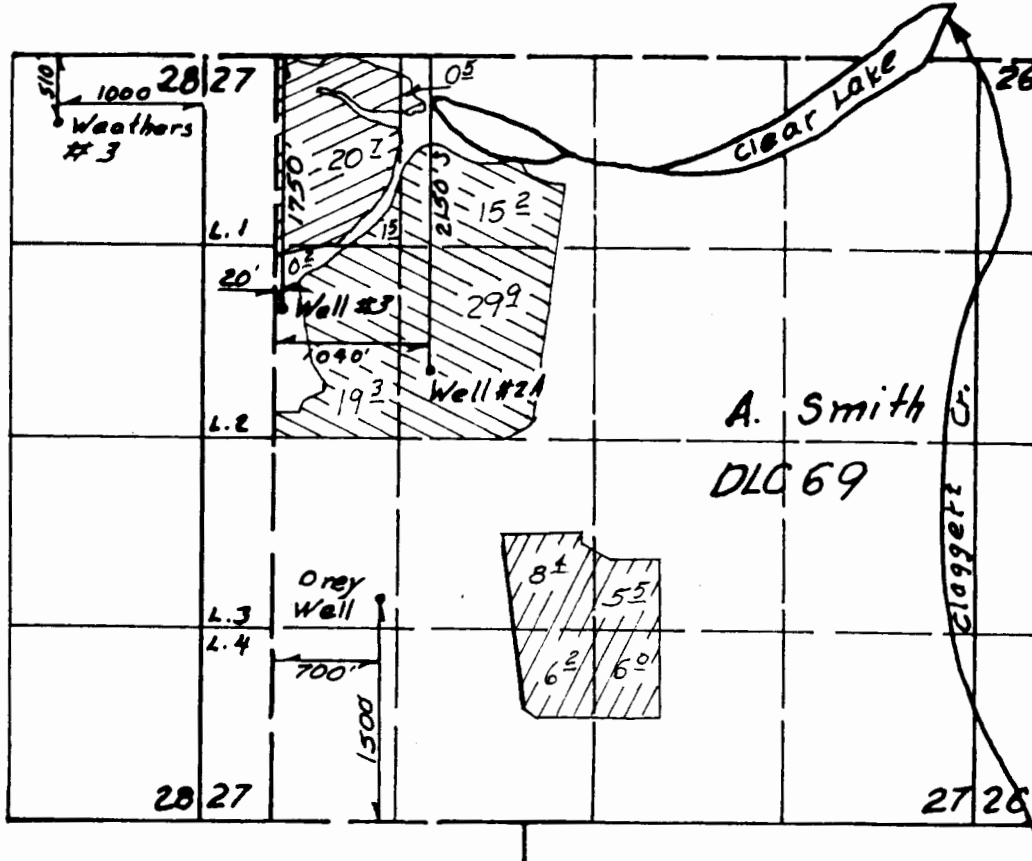
 

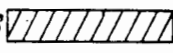


T. 6 S. R. 3 W. W.M.



Scale
4" = 1 Mi.

Cert. 35019  Wells #2
Well #3

Cert. 57923 

FINAL PROOF SURVEY UNDER

Transfer No. T-7020
~~Application No. G-14297 Permit No. G-13104~~
 IN NAME OF

.....MILLER FOREST, INC.

Surveyed Mar. 22., 2000, by

THIS MAP WAS PREPARED FOR THE
 PURPOSE OF IDENTIFYING THE LOCA-
 TION OF A WATER RIGHT ONLY AND IS
 NOT INTENDED TO PROVIDE LEGAL
 DIMENSIONS OR LOCATION OF PROPER-
 TY OWNERSHIP LINES.

