


FINAL PROOF MAP  
 SECTION 33, T.25S. R.14E., W.M.  
 Tax Lot 104  
 LAKE COUNTY, OREGON  
 KEN & KATHY KRUSE  
 T-#7217

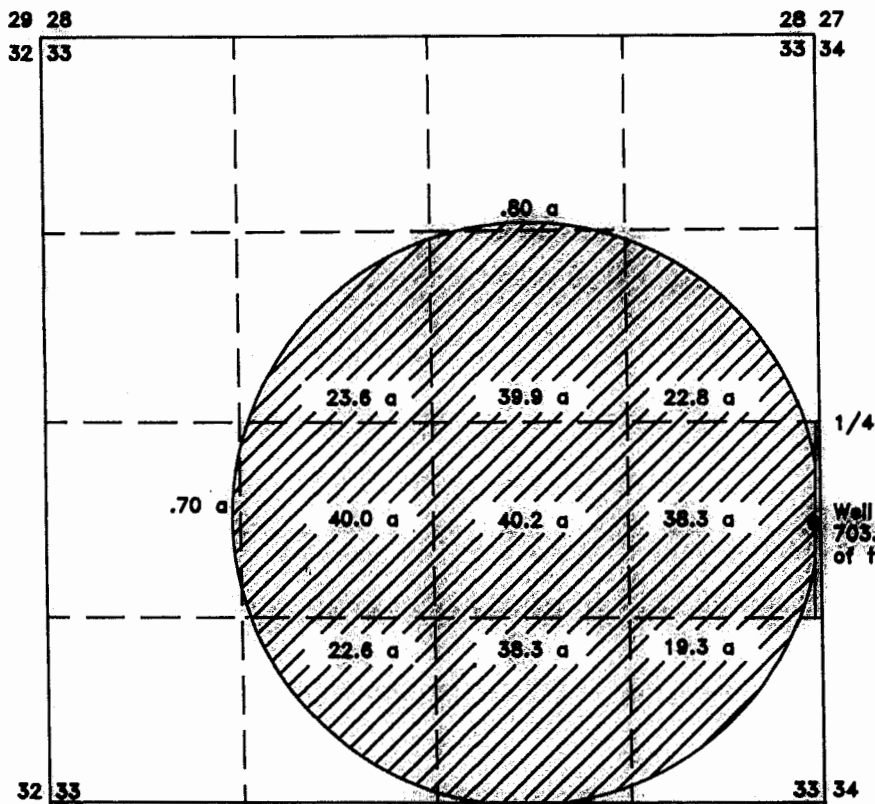

SCALE  
 1" = 1320'



Surveyed by: Sundet & Associates  
 P.O. Box 1228  
 Lakeview, OR 97630  
 541-947-3293  
 February 1999 DR #10099



MAR 02 1999

WATER RESOURCES DEPT.

This map is for the purpose of identifying the location of the water right only and is not intended to provide legal dimensions or location of property ownership lines.