


T. 24 S., R. 33 E., W.M.

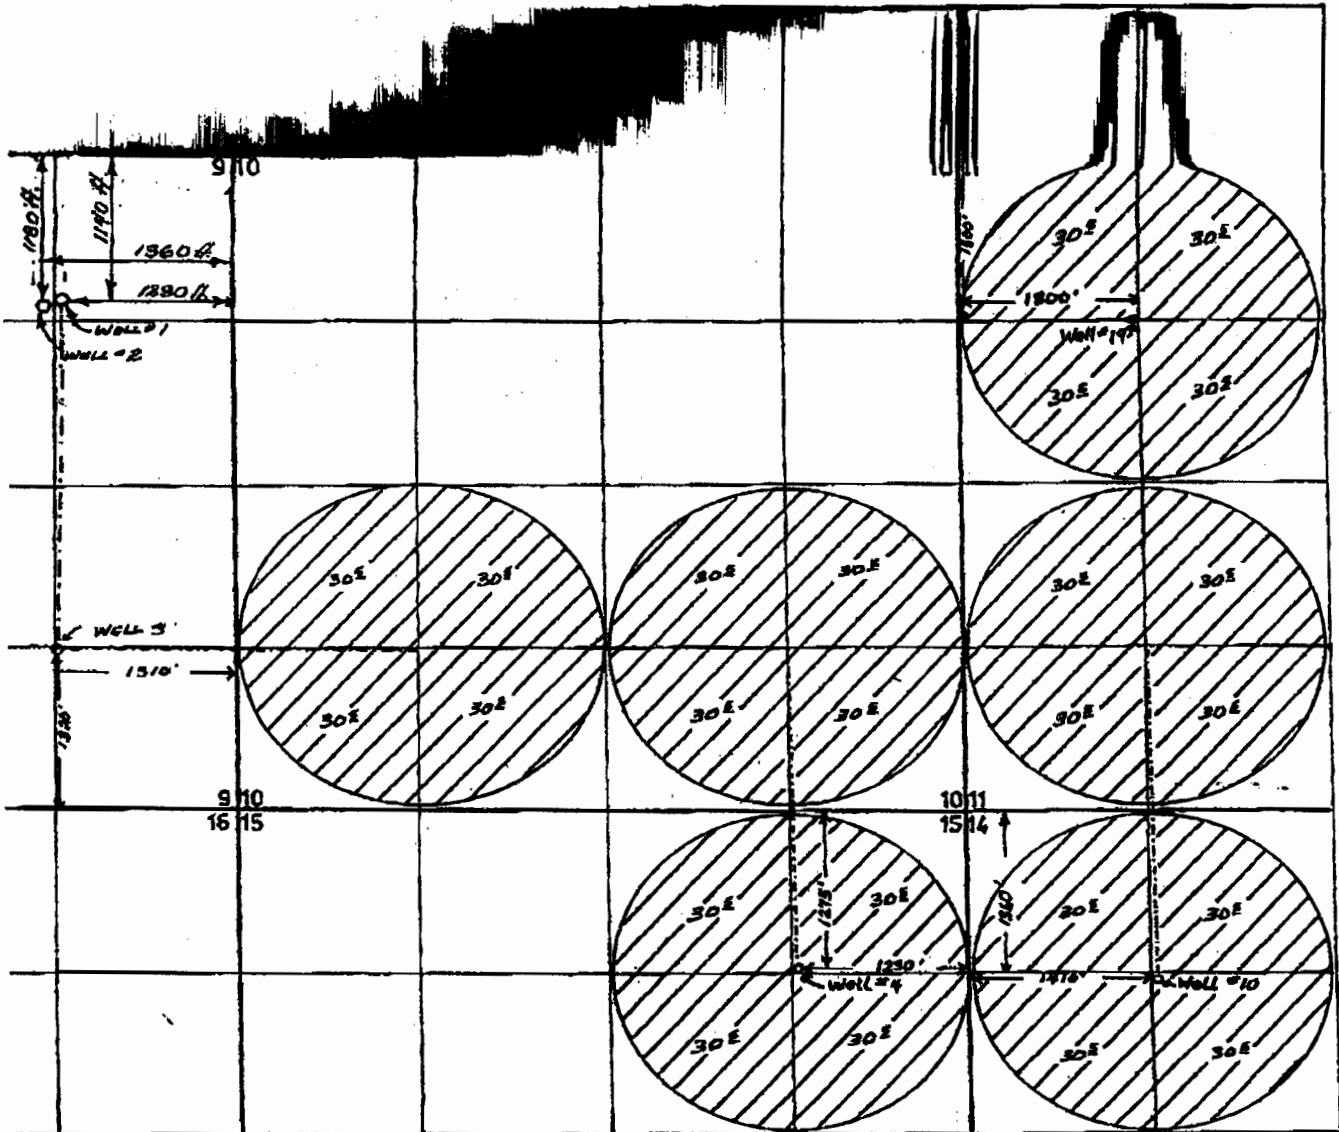


FINAL PROOF SURVEY UNDER

Application No. G-11250 Permit No. G-10390
IN NAME OF

Walter McEwen Estates

Surveyed 10-29, 1990, by K.KEMP

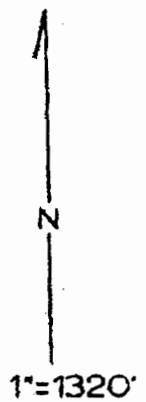

Revised 3-18-99 *JK*
Drafted 3-13-1993 *41025-179-112R, 113R*