


# T.1N., R.32E., W.M.

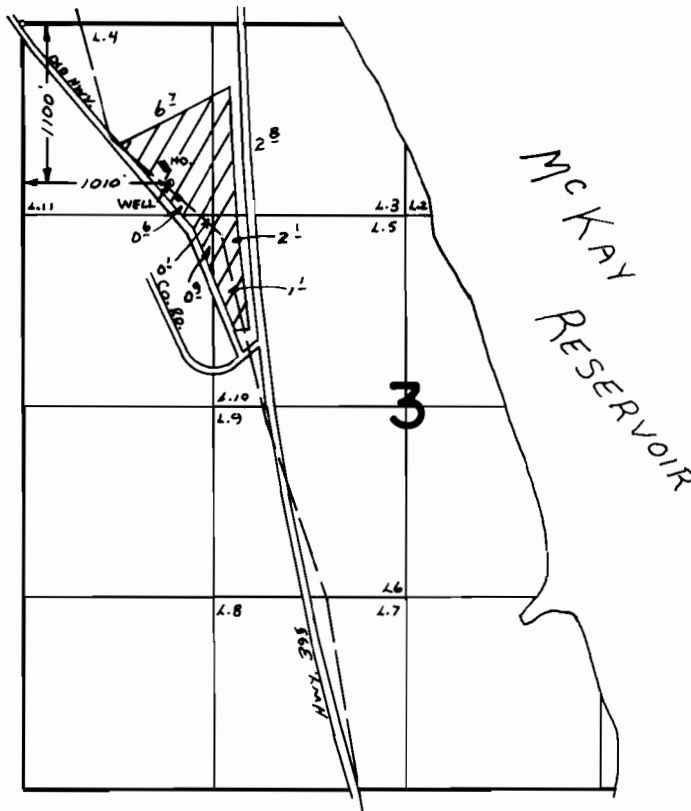

## FINAL PROOF SURVEY UNDER

Application No. G-6195. Permit No. G-5865.  
IN NAME OF

BRUCE A. MALCOM

Surveyed APRIL 8, 1976, by L. T. T. T.