


# T. 2N., R. 24E., W.M.

MORROW COUNTY

SCALE 1" = 1320'

**RECEIVED**  
 OCT 04 2004  
 WATER RESOURCES DEP  
 SALEM, OREGON

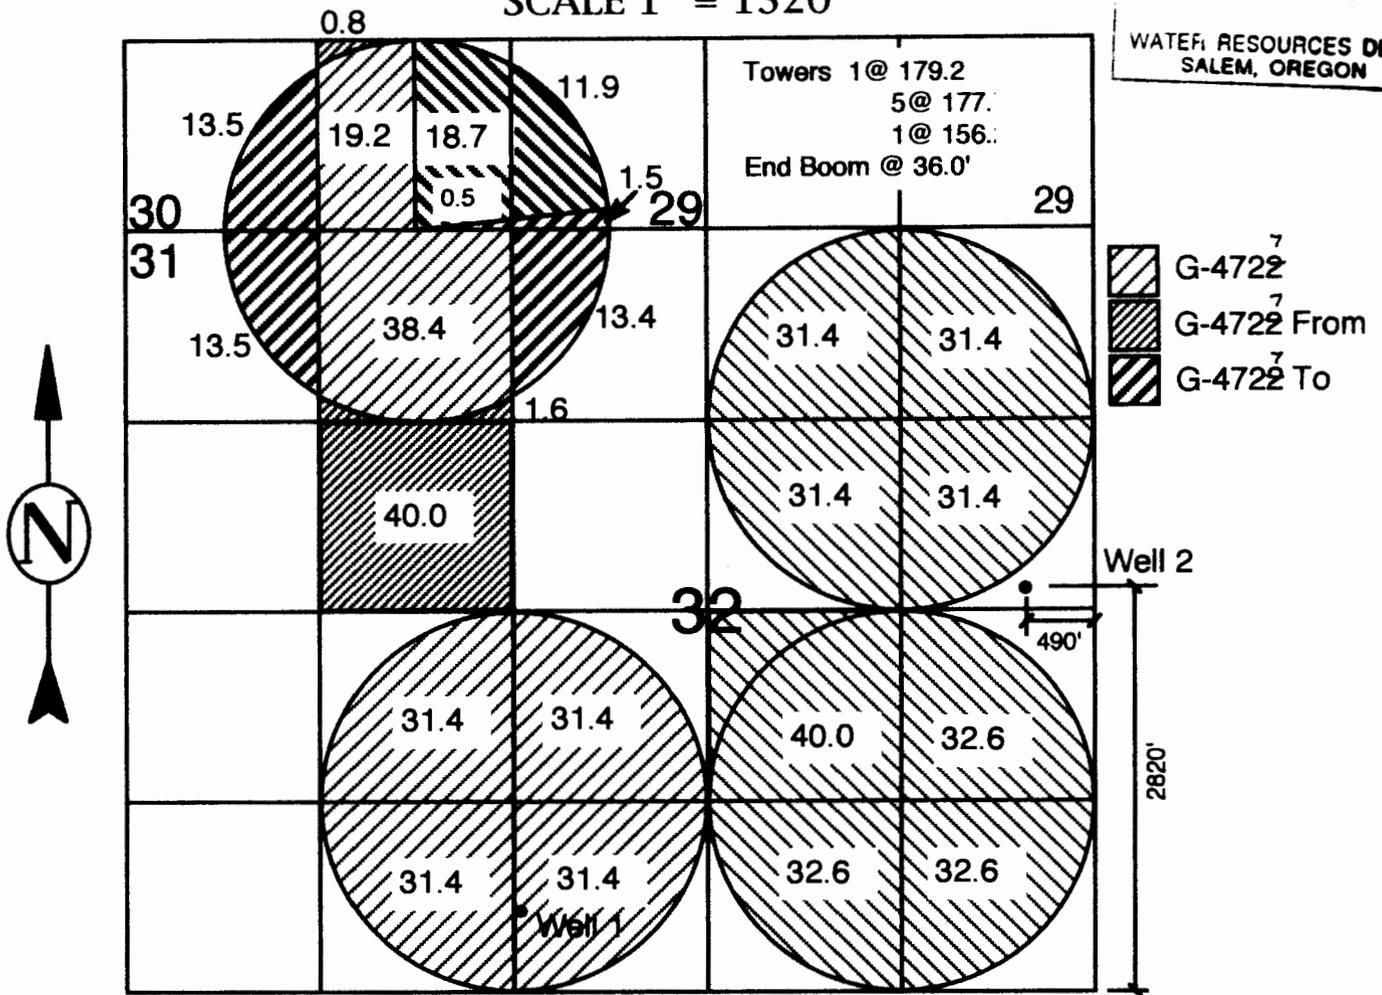

Well 2 Loc. 2820' North & 490' West of SE Corner Section 32  
 Lat. 45°36'40.0776 North, Lon. 119°50'00.5414 West

## WATER RIGHTS PROOF MAP

Water Rights Found at These Locations  
 IN NAME OF

**Ralph & Ann Morter**

THIS MAP IS FOR THE PURPOSE  
 OF IDENTIFYING THE LOCATION  
 OF WATER RIGHTS ONLY AND IS  
 NOT INTENDED TO PROVIDE THE  
 LEGAL DIMENSIONS OR LOCATIONS  
 OF PROPERTY OWNERSHIP LINES.

-  G-4727 Undisturbed
-  G-4727 Proofed

*Certified Water Right Engineer*  
 #202  
 RONALD V. McKINNIS  
 NOV 29 1988  
 STATE OF OREGON  
 Exp. 12-31-04

ENGINEERING - LAND SURVEYING - WATER RIGHTS  
**R. V. McKINNIS ENGINEERING**  
 79980 Prindle Loop Road  
 Hermiston, Oregon 97838  
 (541) -567-2017

*Updated Permit Number to G-4727. MB/wrd 6-15-15*