
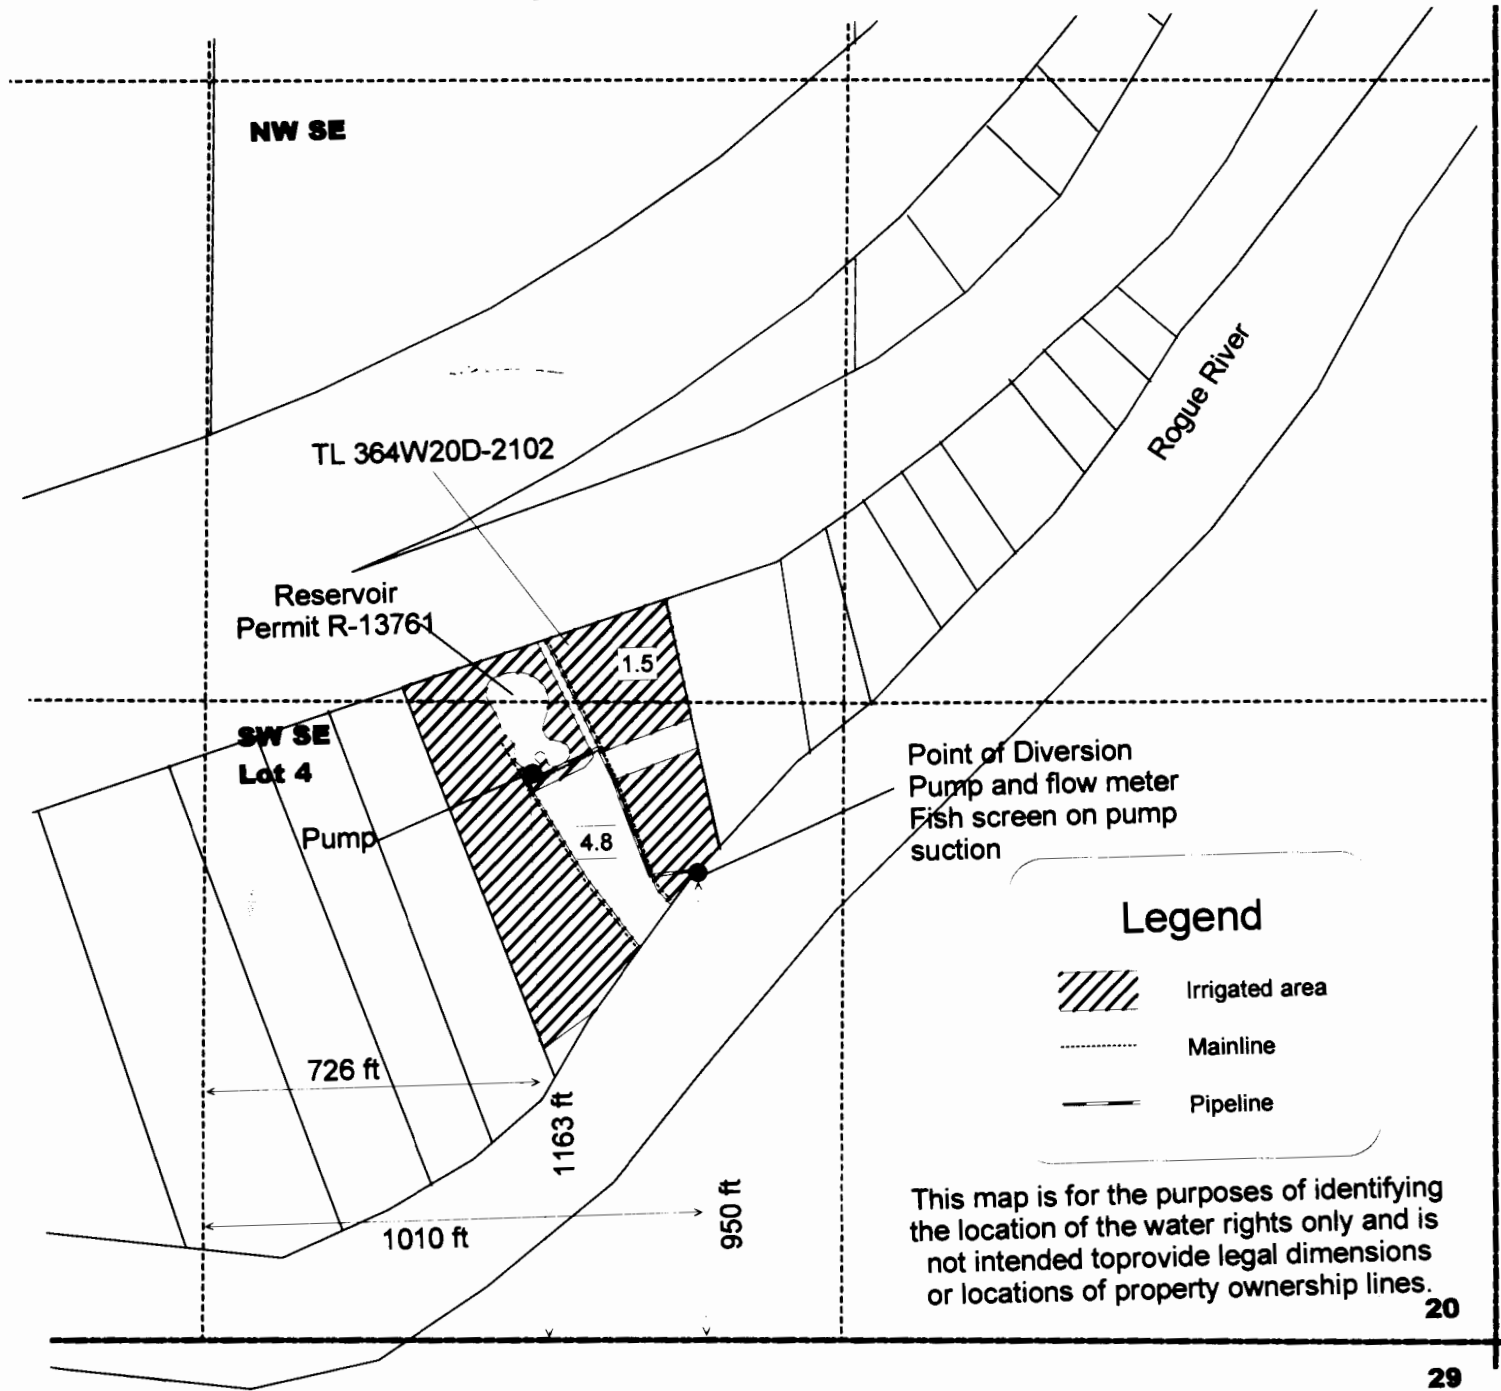



**Claim of Beneficial Use
in Jackson County
Township 36 S, Range 4 W, Section 20, W.M.**


**Kensett J. Moyle
Application S-85328 Permit 53979
Application R-85638 Permit R-13761**

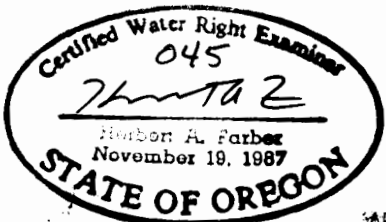


 Certified Water Right Examiner
 045
Theresa Z
 Thurbon A. Farber
 November 19, 1987
STATE OF OREGON
 RENEWAL DATE 12-31-07

RECEIVED
 NOV 17 2006
 WATER RESOURCE STATE 1" = 400'
 SALEM OREGON

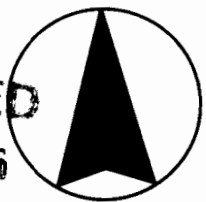


FARBER SURVEYING
 PO Box 5286
 Central Point, Oregon 97502
 Phone 541-664-5599
 Fax 541-664-5603
 Email hfarber@charter.net
