T. 20 & 21 S., R. 22 E., W.M.

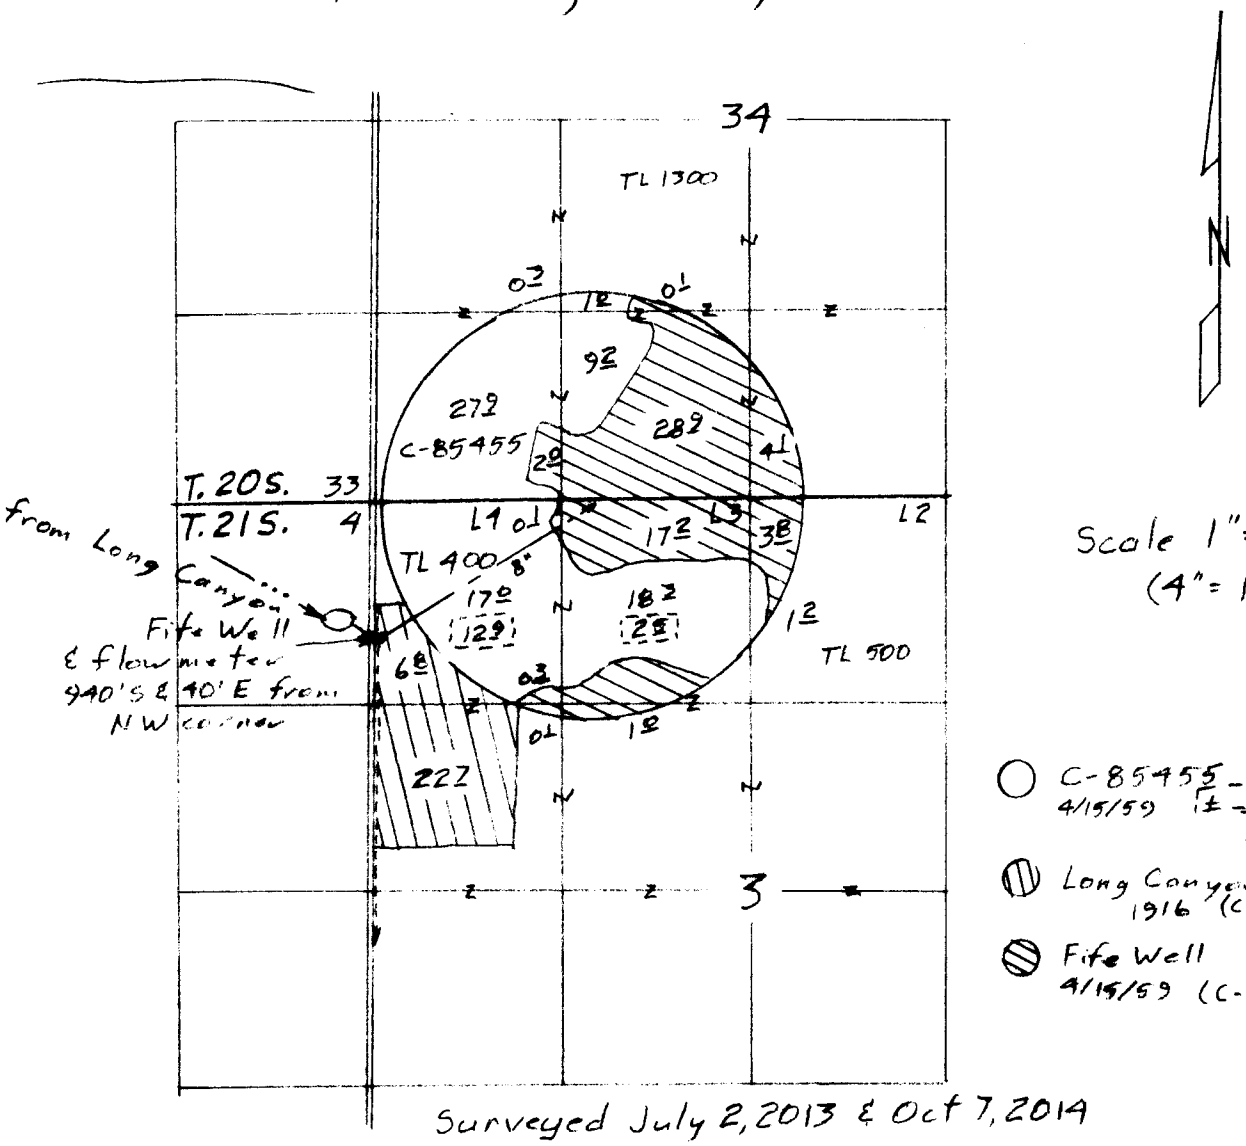

N

Scale 1" = 1320'
(4" = 1 mile)

○ C-85455 – 74 2
4/15/59 ± – 15 7/1
90 3 acres

◐ Long Canyon 29 5
1916 (C-2761)

◐ Fife Well 57 6
4/15/59 (C-33372)

Surveyed July 2, 2013 & Oct 7, 2014

T-8416

Claim of Beneficial Use Map for GI Ranch

RECEIVED BY OWRD

JAN 23 2015

SALEM, OR

This map is for the purpose of locating a water right only and has no intent to provide legal dimensions or the location of property lines.

Certified Water Right Examiner #1
Bruce A. Estes
Nov 19 1987
STATE OF OREGON

Renewal Dec 31, 2015

ESTES SURVEYS, LLC
~~PO Box 17510~~
~~Salem, OR 97305-7519~~
~~(503) 585-7893~~
60382 Am[illegible]
Bend, OR 97702
(541) 382-7391