


T. 20 & 21 S., R. 22 E., W.M.

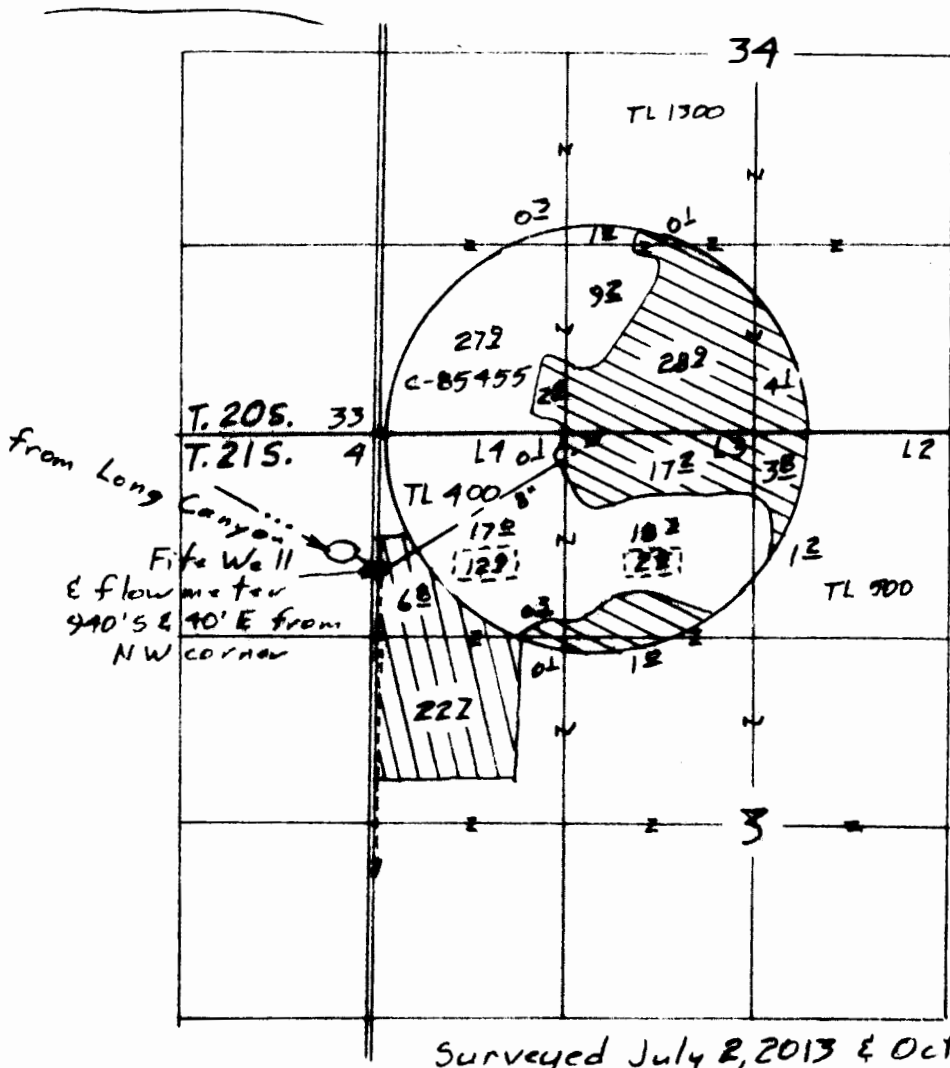

Scale 1" = 1320'
(4" = 1 mile)

- C-85455-722
4/15/59 ± 15.1
90.2 acres
- ⊖ Long Canyon 29E
1916 (C-2761)
- ⊙ Five Well 576
4/15/59 (C-35372)

Surveyed July 2, 2013 & Oct 7, 2014


Claim of Beneficial Use Map for GI Ranch

T-8416

RECEIVED BY OWRD

JAN 23 2015

SALEM, OR

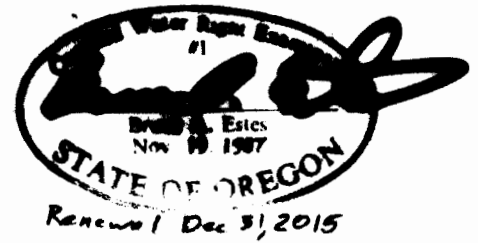

This map is for the purpose of locating a water right only and has no intent to provide legal dimensions or the location of property lines.

ESTES SURVEYS, LLC
 PO Box 12810
 Salem, OR 97309-0810
 (503) 285-7800
 60382 Arnold Rd
 Bend, OR 97702
 (541) 382-7391