


TOWNSHIPS 20 & 21 SOUTH, RANGE 22 EAST, W.M.

RECEIVED BY CWRD

AN 00201  
SALEM OR

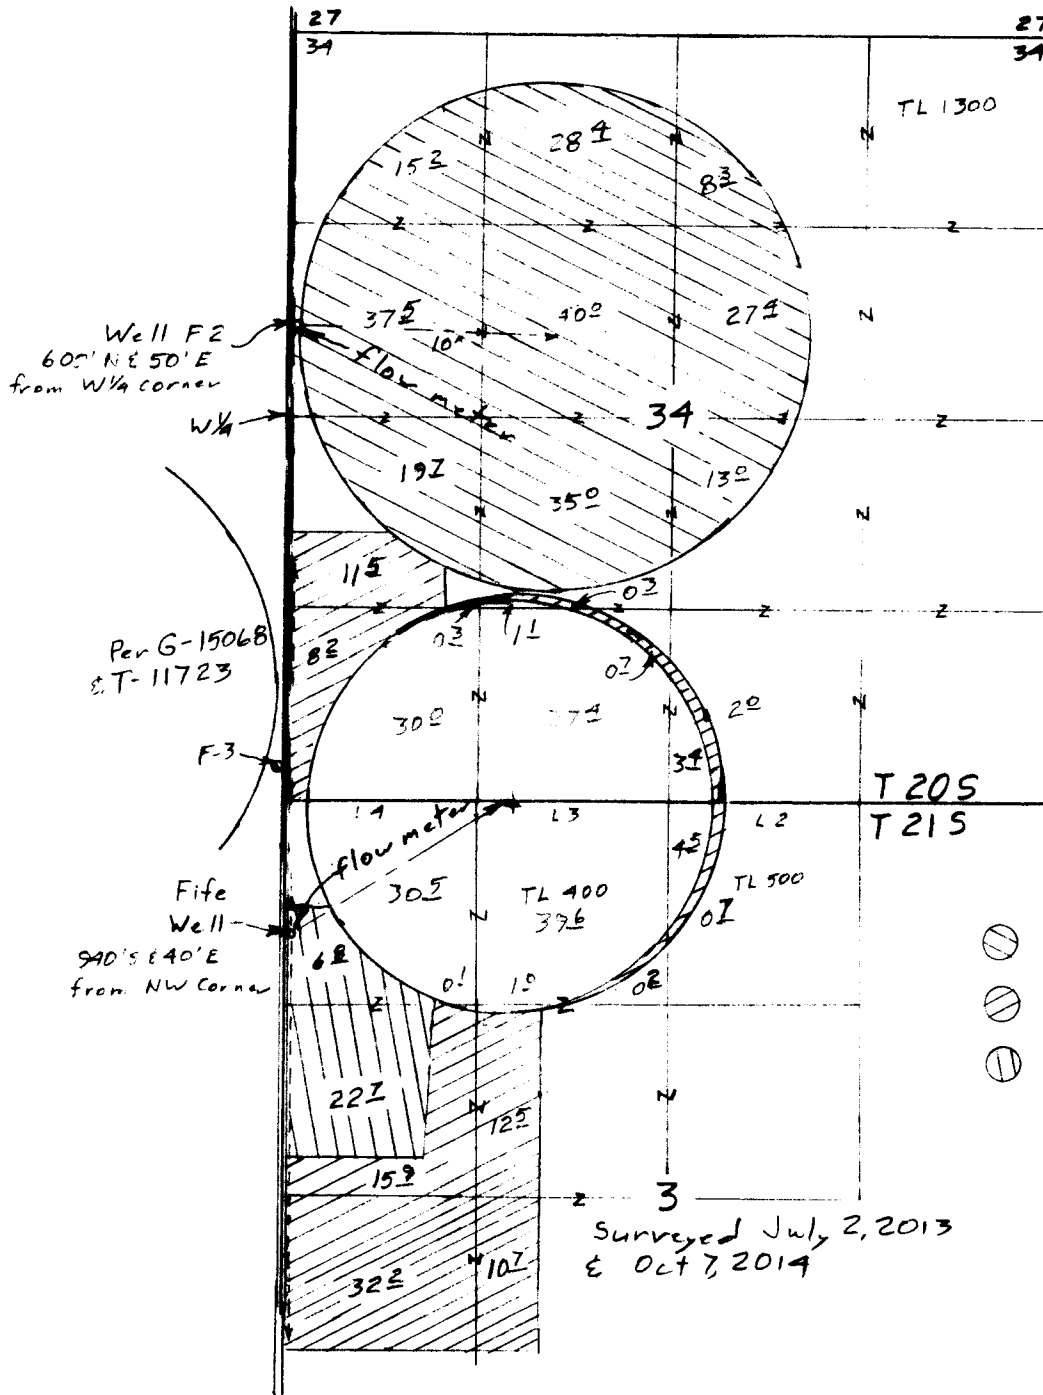


Scale 1" = 1320'  
(4" = 1 mile)

App G-15171  
Per G-15040

- ⊙ Well F-2 224 $\frac{1}{2}$  acres
- ⊙ Fife Well Primary 94 $\frac{1}{2}$  acres
- ⊙ Fife Well Supplemental 29 $\frac{1}{2}$  acres

Surveyed July 2, 2013  
& Oct 7, 2014

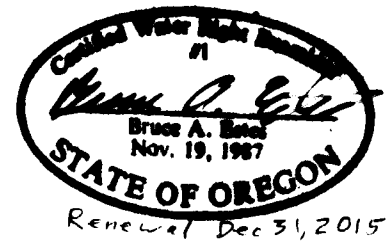

Claim of Beneficial Use Map  
for  
GI Ranch

This map is for the purpose of locating a water right only and has no intent to provide legal dimensions or the location of property lines.

**ESTES SURVEYS, LLC**  
 PO Box 47640  
 Salem, OR 97305-7519  
 (503) 586-7800  
 60382 Arnold Rd  
 Bend, OR 97702  
 (841) 382-7391