


TOWNSHIPS 20 & 21 SOUTH, RANGE 22 EAST, W.M.

Gravel Pivot
239⁰ acres

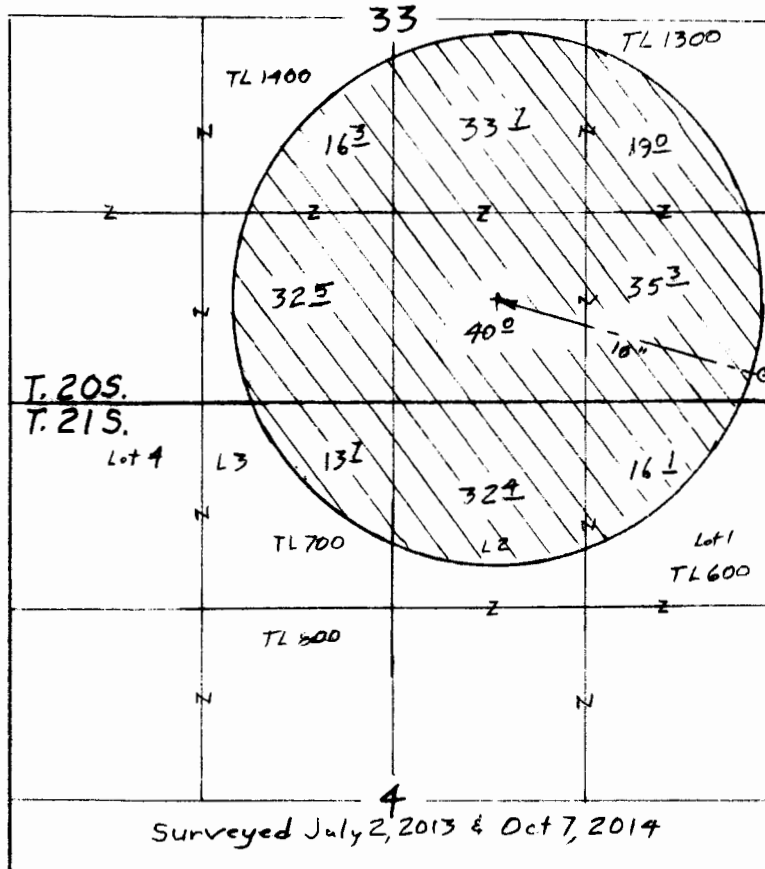

flow meter
Well F-3
160' N &
80' W from
SE Corner

Scale 1" = 1320'
(4" = 1 mile)

Surveyed July 2, 2013 & Oct 7, 2014

⊗ G-17237 239⁰ acres

Claim of Beneficial Use Map
for
GI RANCH

App G-15223
Per G-17237
App G-15657
Per G-17178
PA T-11723




Renewal Dec 31, 2015
Sheet 1 of 2

This map is for the purpose of
locating a water right only
and has no intent to provide
legal dimensions or the location
of property lines.

ESTES SURVEYS, LLC
PO Box 17519 Salem, OR 97305-7519 (503) 688-7500
60382 Arnold Rd Bend, OR 97702 (541) 382-7391

T. 20S, R. 22E, W.M.

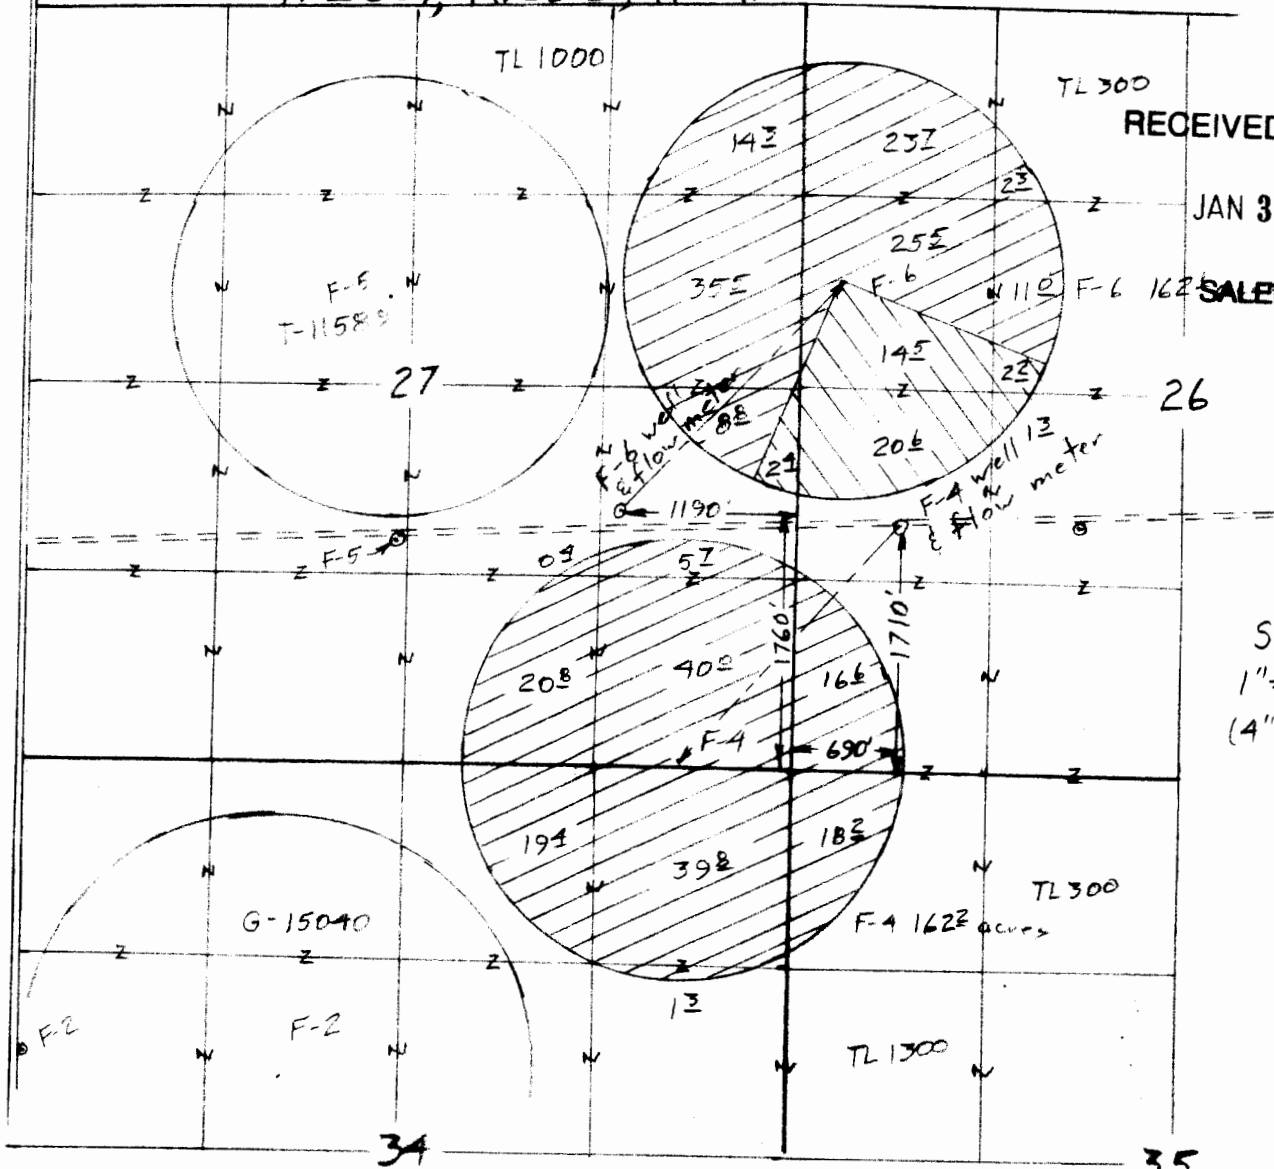

RECEIVED BY OWRD

JAN 30 2015

SALEM, OR

Scale
1" = 1320'
(4" = 1 mile)

Surveyed July 2, 2013 & Oct 7, 2014

- ⊗ F-6 G-17237 41² acres
- ⊗ G-17178 F-4 162³ & F-6 121⁴ acres

App G-15223
 Per G-17237
 App G-15657
 Per G-17178
 PA T-11723

Claim of Beneficial Use Map
 for
 G1 Ranch Corp.



Sheet 2 of 2

This map is for the purpose of
 locating a water right only
 and has no intent to provide
 legal dimensions or the location
 of property lines.

ESTES SURVEYS, LLC
 PO Box 43846
 Salem, OR 97304-7846
 (503) 325-7800
 80382 Arnold Rd
 Bend, OR 97702
 (541) 323-7301