


T. 20S, R. 22E, W.M.

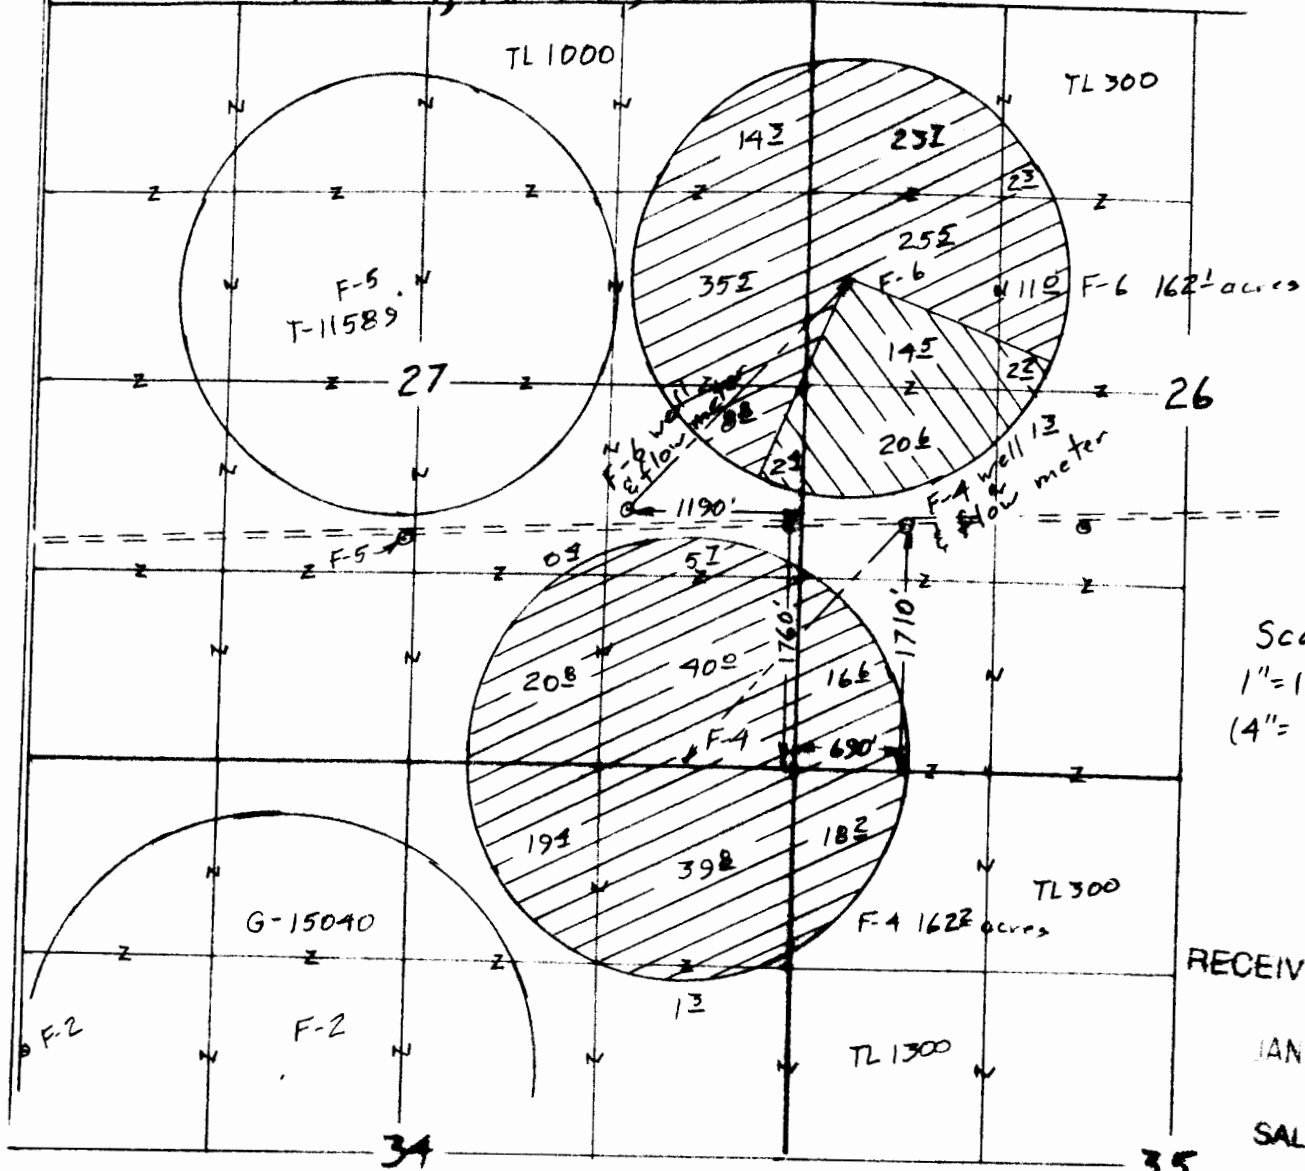

Scale
1" = 1320'
(4" = 1 mile)

RECEIVED BY OWNER

JAN 20 2015

SALEM, OR

Surveyed July 2, 2013 & Oct 7, 2014

- ⊗ F-6 G-17237 41² acres
- ⊗ G-17178 F-4 162²/₃ & F-6 121¹/₂ acres

App G-15223
 Per G-17237
 App G-15657
 Per G-17178
 PA T-11723

Claim of Beneficial Use Map
 for
 G1 Ranch Corp.



Sheet 2 of 2

This map is for the purpose of
 locating a water right only
 and has no intent to provide
 legal dimensions or the location
 of property lines.

ESTES SURVEYS, LLC
 PO Box 4888
 Salem, OR 97302-0488
 (503) 325-7888
 20002 Arroyo Rd
 Salem, OR 97302
 (541) 382-7291