



0 660 1,320 2,640 3,960 5,280 Feet
 1" = 1320'

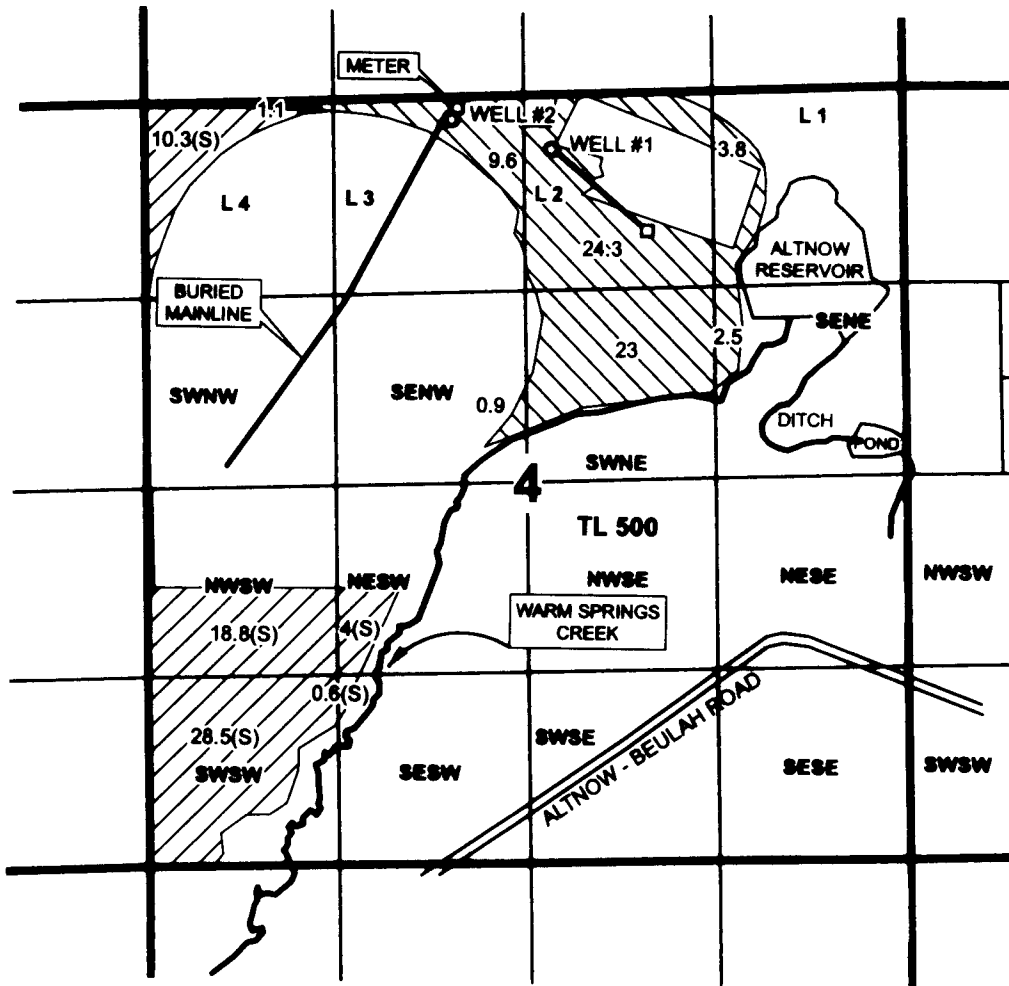

HARNEY COUNTY, OREGON
 T 20 S, R 36 E, WM
 SECTION 4



- WELLS
- METERS
- WATER COURSES
- PRIMARY PLACE OF USE
- SUPPLEMENTAL PLACE OF USE

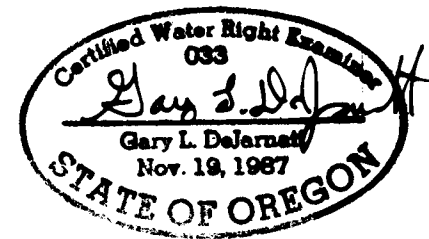

WELL # 1 - 375' S, 200' E OF N 1/4 CNR
 WELL # 2 - 180' S, 500' W OF N 1/4 CNR
 TL 500 EXCEEDS 3,000 ACRES INCLUDING ALL OF SECTION 4

RENEWAL DATE: 12/31/2015

**CLAIM OF BENEFICIAL USE MAP
 FOR COTTONWOOD CREEK RANCH**

APPLICATION G-17728 PERMIT G-17219

NOTE: THIS MAP IS NOT INTENDED TO
 PROVIDE LEGAL DIMENSIONS OR LOCATIONS
 OF PROPERTY OWNERSHIP LINES.

JOB # 14054 AUGUST 28, 2014

WATER RIGHT SERVICES, LLC

PO BOX 1830, BEND, OR 97709

CCB # 197121 WWW.OREGONWATER.US
 541-389-2837 JOHNSHORT@USA.COM