

SECTION 28, T.1S., R.3W., W.M.

WASHINGTON COUNTY, OREGON

1/4 COR.

20 21
29 28

MAP BASE:
ASSESSORS MAP
SCALED COLORED
PHOTO

PREPARATION OF THIS MAP IS FOR THE
PURPOSE OF IDENTIFYING THE LOCATION OF
THE WATER RIGHT ONLY. THERE IS NO INTENT
TO PROVIDE DIMENSIONS OR LOCATION OF
PROPERTY OWNERSHIP LINES.



SCALE: 1"=400'

RECEIVED

JUN 25 2004

PLANNING & ENGINEERING

GNOS ROAD

T.L. 300

2320'

2320'

930'

1675'

WEST 1/4 COR.


RES. #3

RES. #1

FINAL PROOF SURVEY

UNDER

APPLICATION PERMIT
R-84041 R-12735
SURVEYED JUNE 25, 2004

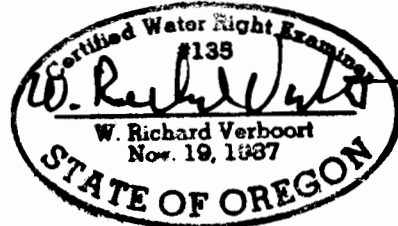

VERBOORT ENGINEERING
AGRICULTURE · CIVIL · WATER RESOURCES
HILLSBORO, OREGON

by date
designed WRV 06/04
drawn JFR 06/04
checked WRV 06/04
drawing no. 04-A-08
sheet no. 1 / 1

RON HOCHSTEIN

38100 S.W. GNOS RD.
CORNELIUS, OR 97113