

SECTION 28, T.1 S., R.3 W., W.M.

WASHINGTON COUNTY, OREGON

20

21

1/4 COR.

29

28

MAP BASE:  
ASSESSORS MAP  
WAC PHOTO  
FSA 2005 PHOTO



SCALE: 1" = 400'

12.2 Ac.

1255'

1750'

T.L. 300

7.2 Ac.

ROAD

GNOS

2320'

PUMP  
POD #2

550'

RES. #3

STAFF  
GAGE

POD #1

500'

4.5 Ac.

RECEIVED

JAN 10 2006

WATER RESOURCES DEPT  
SALEM, OREGON

WEST  
1/4  
COR

19.4 Ac.

RES. #1

PUMPS  
POD #3

1675'


FINAL PROOF SURVEY

UNDER

APPLICATION 84042

PERMIT 53609

SURVEYED DECEMBER 1, 2005

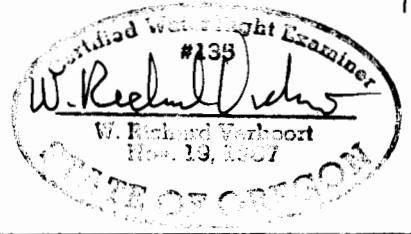

PREPARATION OF THIS MAP IS FOR THE  
PURPOSE OF IDENTIFYING THE LOCATION OF  
THE WATER RIGHT ONLY. THERE IS NO INTENT  
TO PROVIDE DIMENSIONS OR LOCATION OF  
PROPERTY OWNERSHIP LINES.



Stutzner Engineering  
& Forestry, LLC

ENGINEERING • LAND SURVEYING • FORESTRY  
PLANNING • WATER RIGHTS

6000 HWY • FOREST GROVE • OREGON  
8113-A PALM BEACH AVENUE  
BALLAD TOWNE SQUARE  
FOREST GROVE, OREGON 97118

TEL: (503) 387-8717  
FAX: (503) 387-8888  
E-MAIL: stutzner@europa.com

designed	WRV	12/01/05
drawn	JER	12/01/05
checked	WRV	12/01/05
drawing no.	305-2-099	
sheet no.	1/1	

RON HOCHSTEIN

38100 S.W. GNOS RD.  
CORNELIUS, OR 97113