
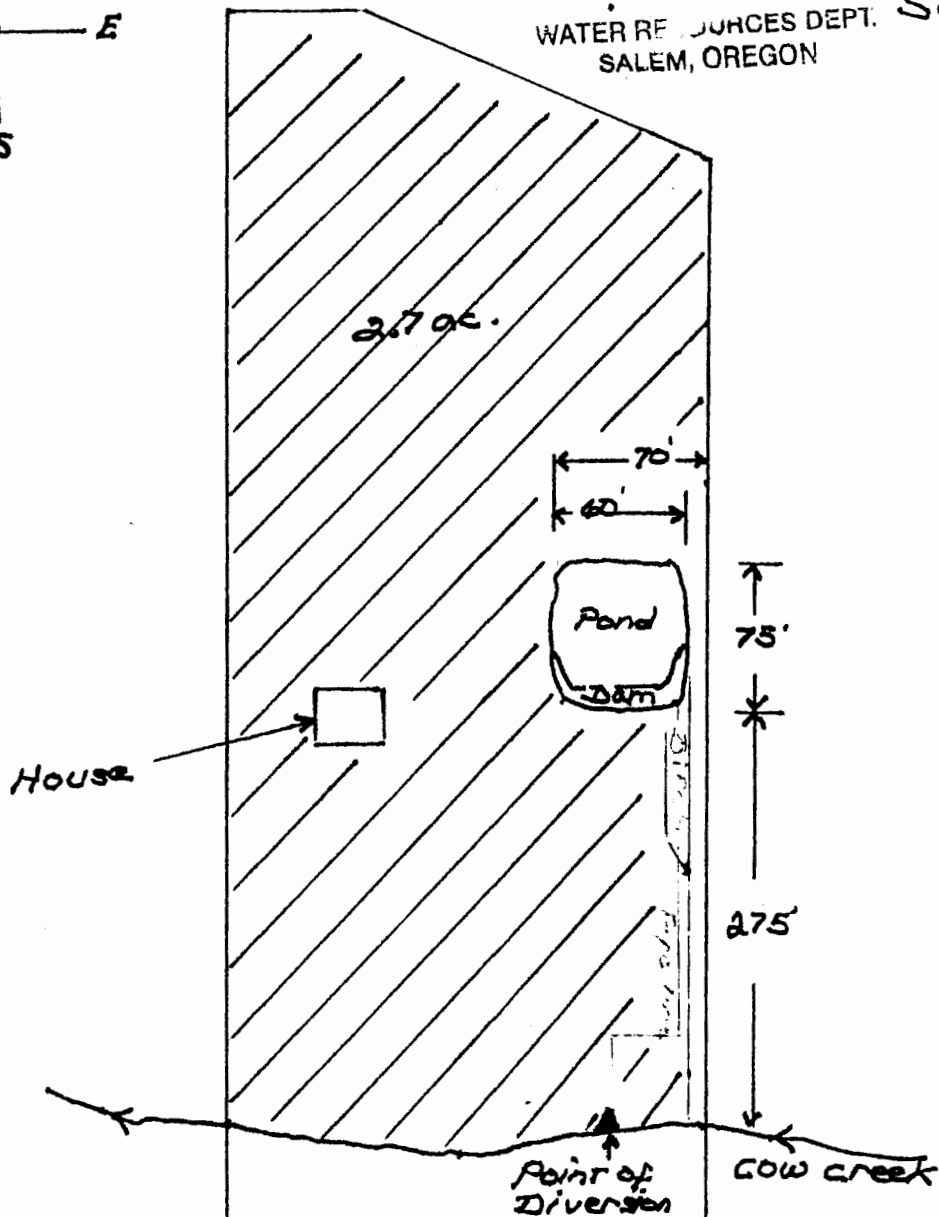


AUG 18 1997
WATER RESOURCES DEPT.
SALEM, OREGON

Scale
1" = 1 mile

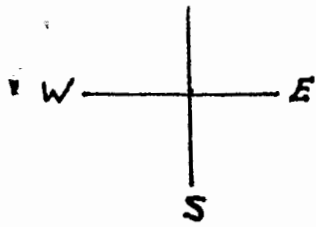

Point of diversion is
370' North & 850' East
of the South $\frac{1}{4}$ Corner
of Section 2

James A. Pack
18537 Upper Cow Creek N
Azalea, Or. 97410

Township 32
Range 3
Section 2
Quarter SW $\frac{1}{4}$ SE $\frac{1}{4}$
Tax lot 800

Application No. 283533
Permit No. 412460

RECEIVED BY OWRD

MAR 18 2014

SALEM, OR