



CLAIM OF BENEFICIAL USE MAP T-9724
 SITUATED IN
 SECTIONS 13 AND 18, TOWNSHIP 40 SOUTH
 RANGES 7 AND 8 WEST, WILLAMETTE MERIDIAN
 JOSEPHINE COUNTY, OREGON
 FOR
 WAYNE O. AND NANCY K. DOLLARHIDE
 3199 HELMS ROAD
 GRANTS PASS, OREGON 97527
 JULY 16, 2009

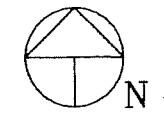

Scale: 1"=400'
 Date: July 16, 2009


This map was prepared for the purpose of identifying the location of a water right only and is not intended to provide legal dimensions or location of property ownership.

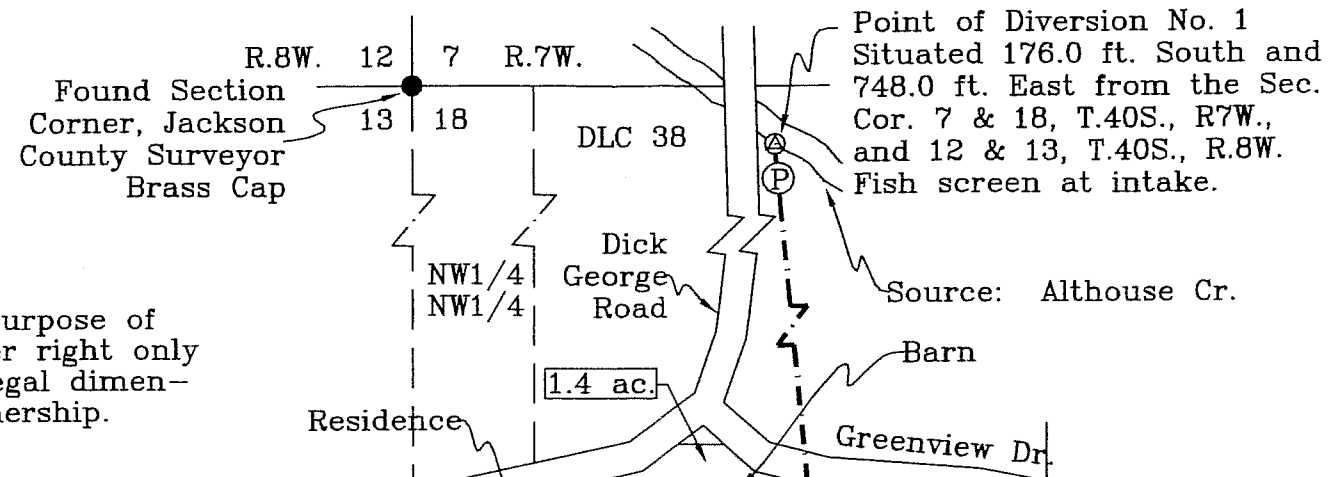

LEGEND


- Found Survey Monument
- - - Denotes Mainline Pipe
- (M) Denotes Flow Meter
- (P) Denotes Primary Pump
- (BP) Denotes Booster Pump
- - - Denotes Donation Land Claim Boundary
- Denotes Building or Structure Location
- - - Denotes Drainage or Ditch Location
- [Diagonal Hatching] Denotes Area Under Cert. No. 53116, Priority Date 1856.
- [Horizontal Hatching] Denotes Area Under Cert. No. 56362, Priority Date 1870.
- [Diagonal Hatching] Denotes Area Under Cert. No. 53632, Priority Date 1856.

Note: DLC and Govt. Lot Lines projected from GLO Record.

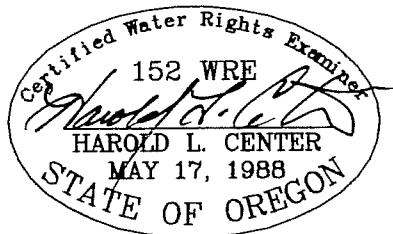

HAROLD L. CENTER
 2604 David Lane
 Medford, OR. 97504
 Phone 541-535-6108
 Oregon Certificate No. 152
 Cert. Renewal Date: 12/31/2009

RECEIVED
 SEP 24 2009
 WATER RESOURCES DEPT
 SALEM, OREGON

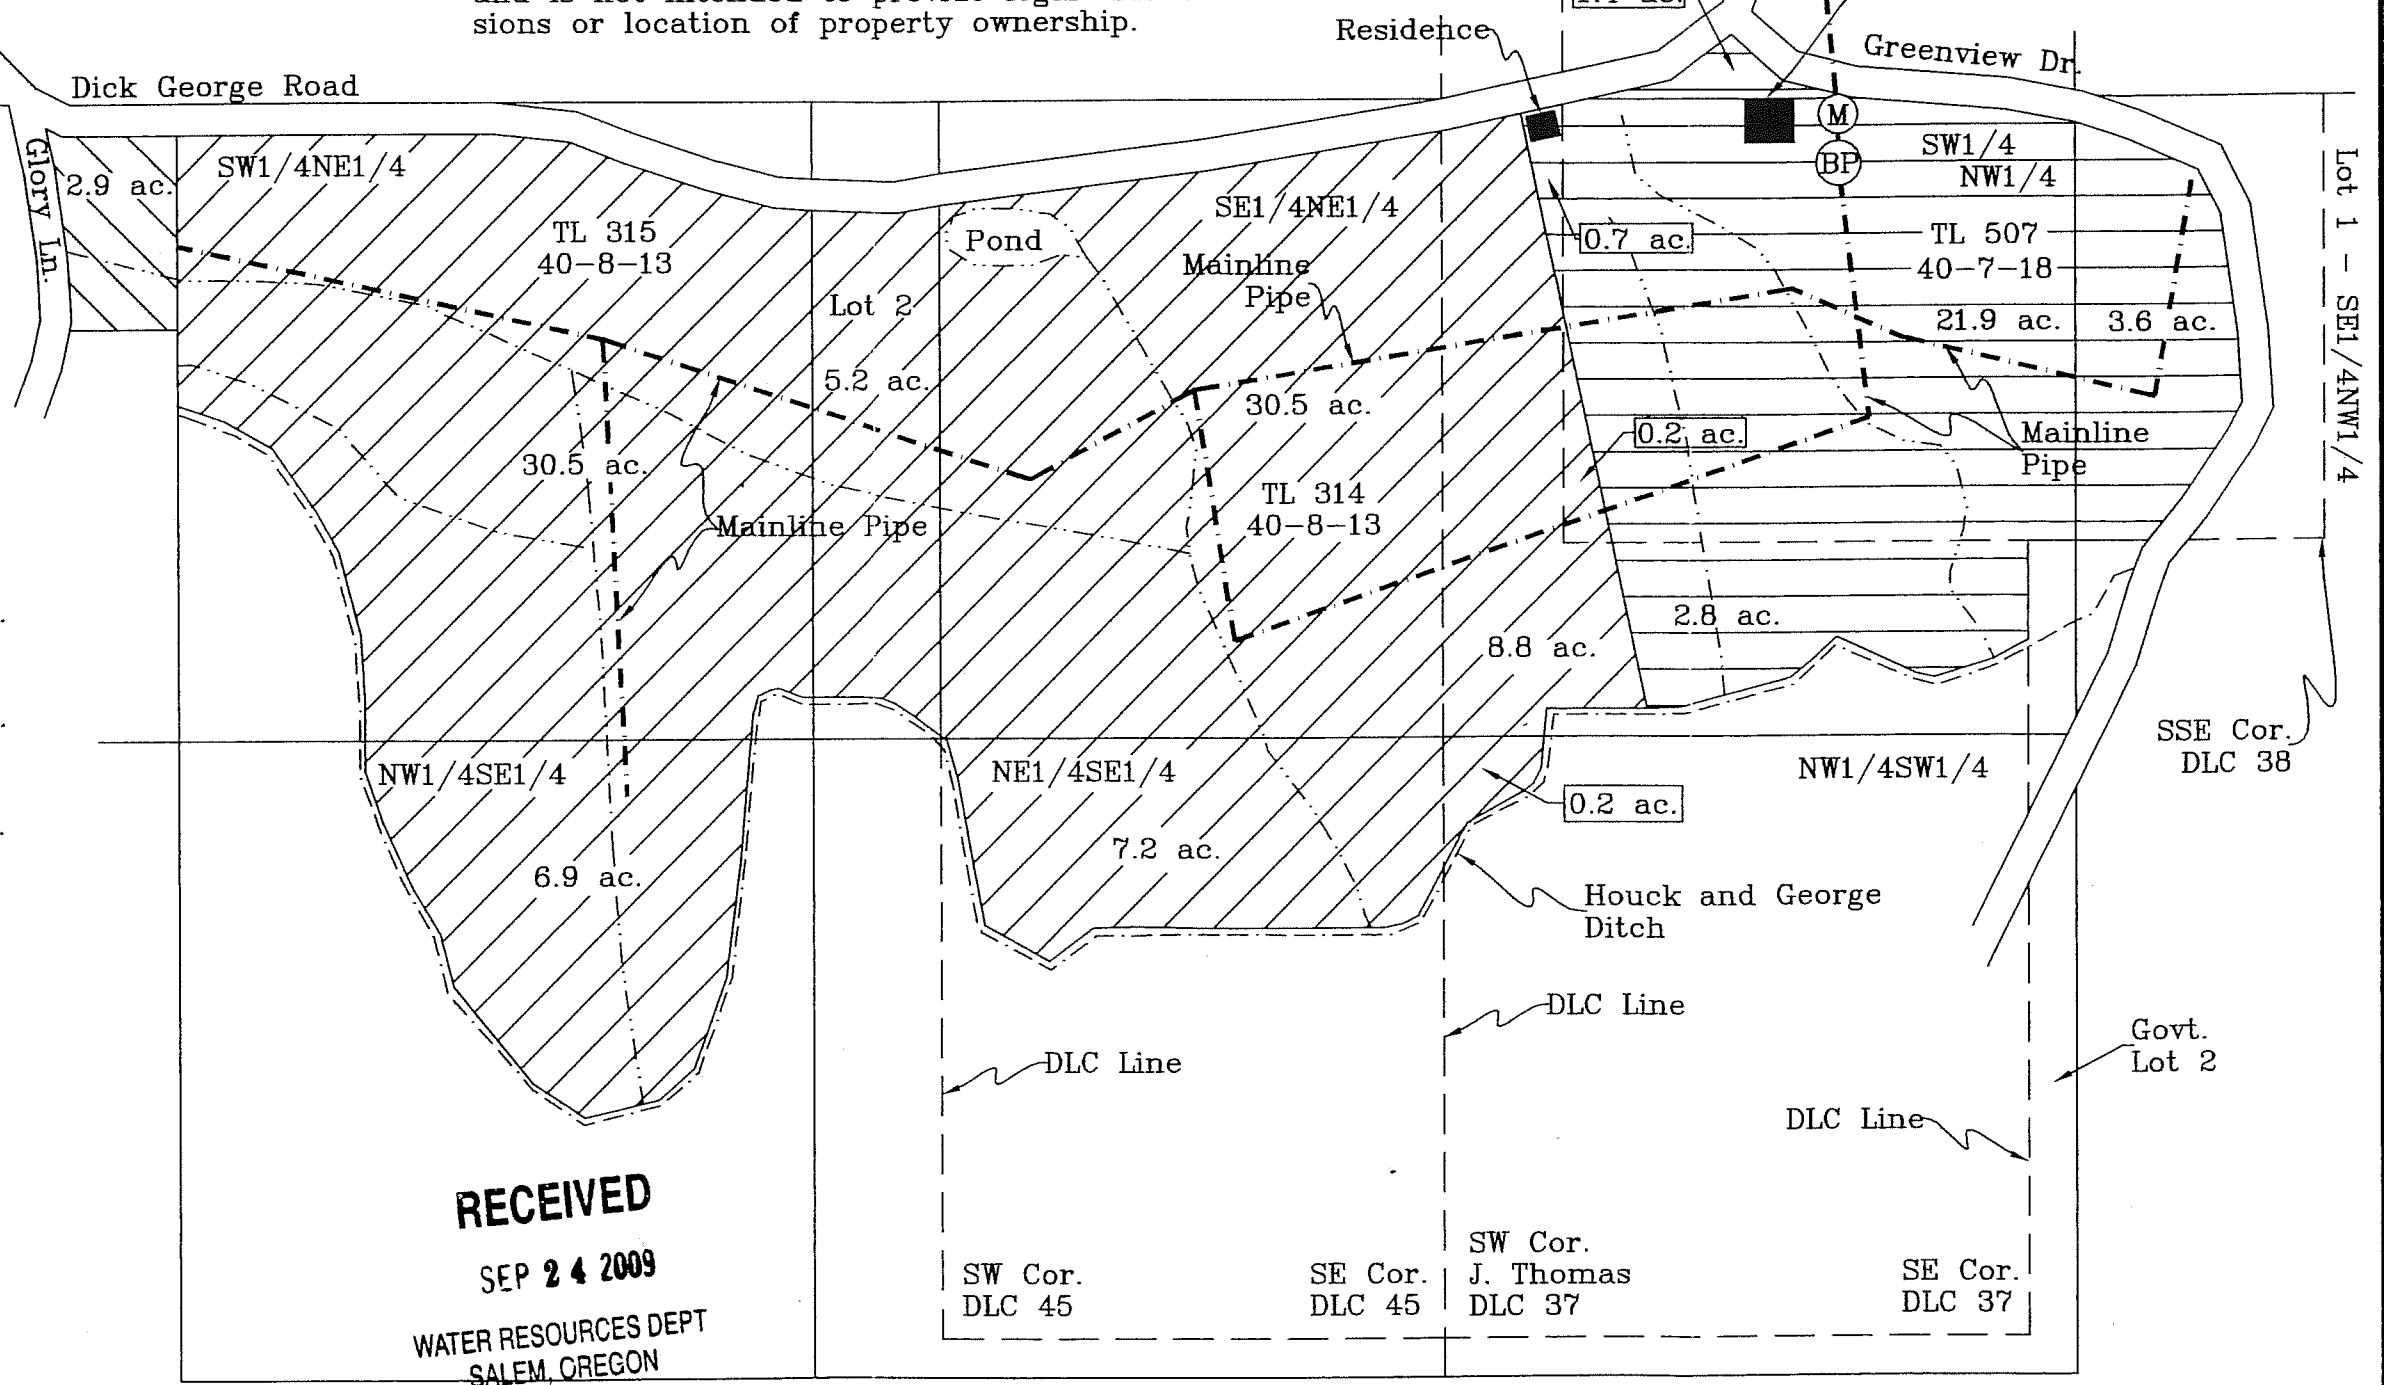

COBU MAP # 0457