
Date: 9/7/2013

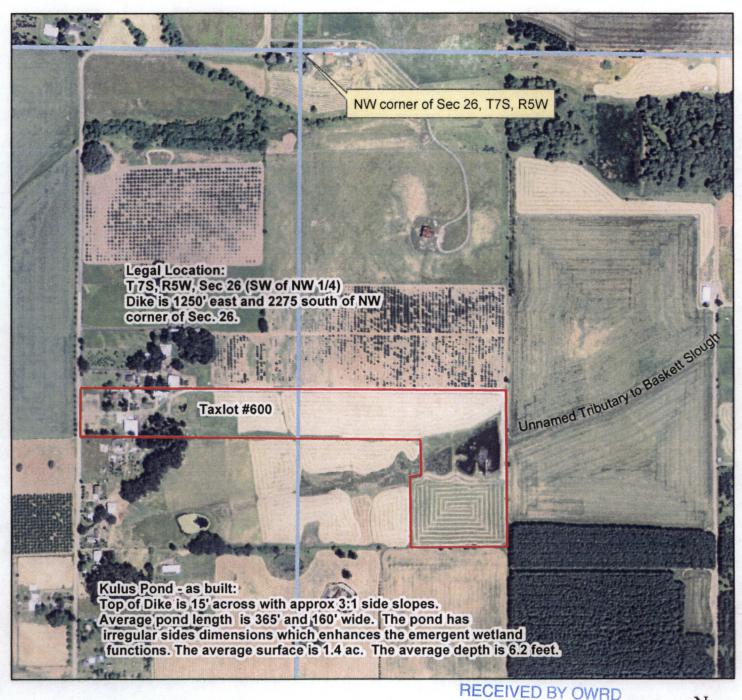

T7S, R5W, Sec.26 TL# 600 Application # R-86075 Permit # R-14100

