



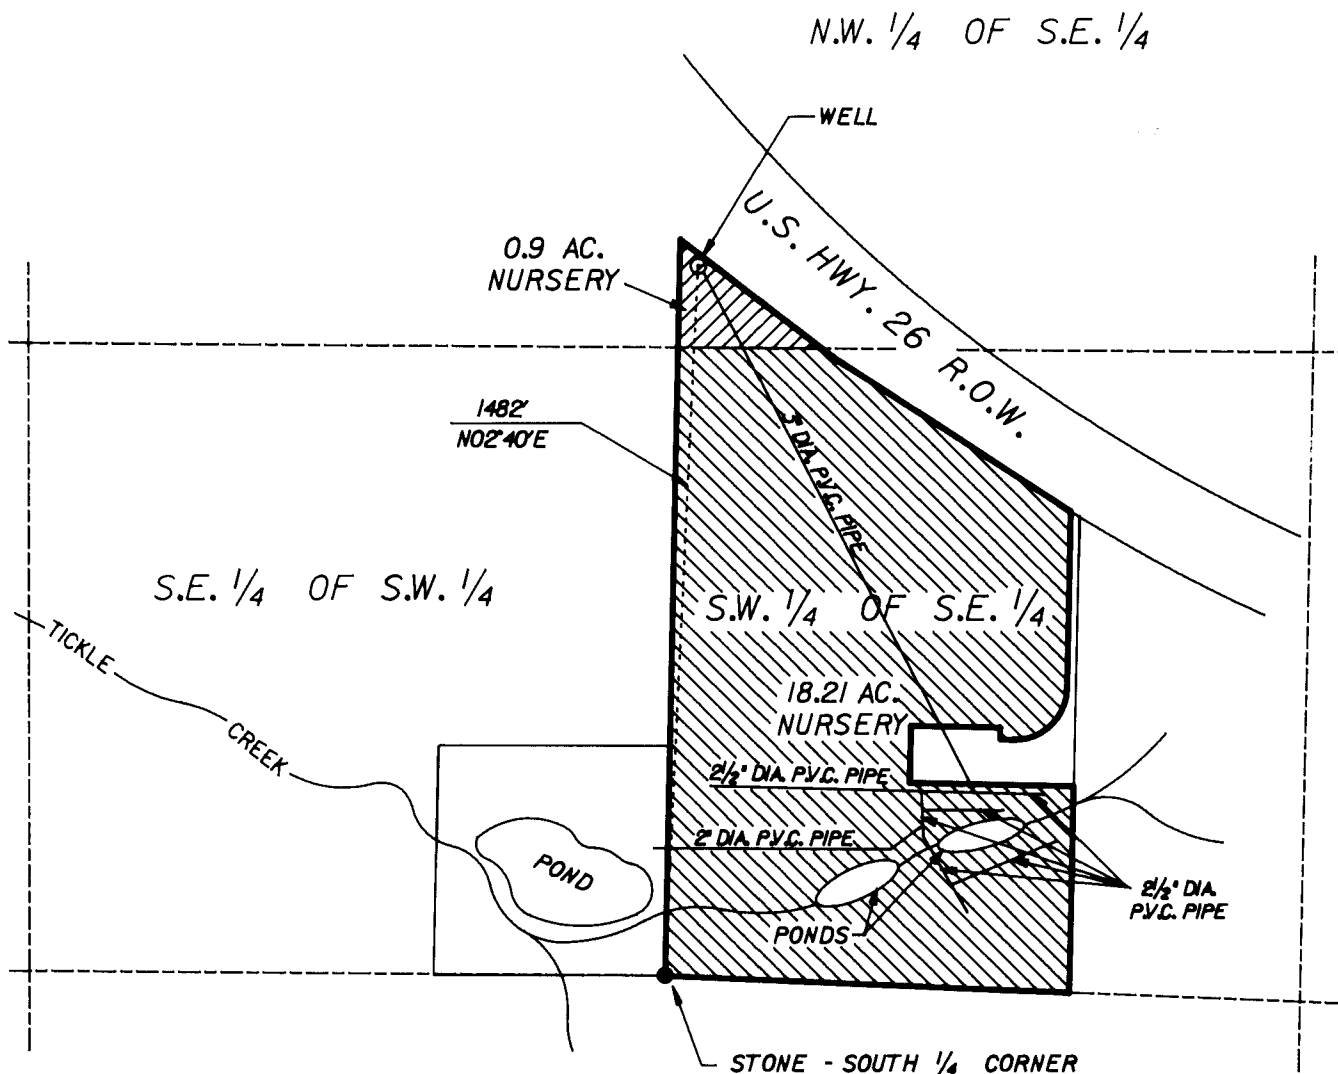

This drawing is a Final Proof Survey for a Ground Water Right. It is not a Land Survey. Property lines and/or other lines of occupation shown hereon are not represented by the undersigned to meet accuracy standards of Land Surveys.

SCALE: 1"=400'

SECTION 10, T. 2S., R. 4E., W.M.  
CLACKAMAS COUNTY, OREGON

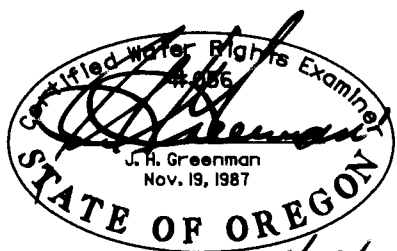

Application No. G-12065

Permit No. G-11171



**HANER, ROSS &  
SPORSEEN, INC.**  
15 S.E. 82ND DRIVE  
GLADSTONE, OREGON 97027

**SOBELLA FARMS  
GROUND WATER RIGHT  
FINAL PROOF SURVEY**

622/Z