

Permit No. 38492,
2.0 ac. transfer from.
Note: Transfer No. 7250
moved 2.0 ac. irr. W.R.
from Permit No. 13637
to here.

NW 1/4 NE 1/4

2.0 ac.
transfer to.
Note: This area not
irrigated & 2.0 ac. of
W.R. Permit No. 38492
lost.

POD Permit No. 38492 is 120 ft.
North & 750 ft. West of the SE section
corner of Section 27.


**CLAIM OF BENEFICIAL USE OF
WATER RIGHT TRANSFER**
in the J. P. Cornelison DLC No. 46 and in the
SE 1/4 SE 1/4 of Section 27 & in the NE 1/4
NE 1/4 of Section 34, T29S, R5W, W.M.,
Douglas County, Oregon

Transfer No. 7251
Permit No. 38492

For: Stephen A. & Melinda D. Roos
P.O. Box 1067
Myrtle Creek, Oregon 97457

By: Shaner Engineering, Inc.
P.O. Box 1430
Roseburg, Oregon 97470

RECEIVED
SEP 17 2001
WATER RESOURCES DEPT.
SALEM, OREGON

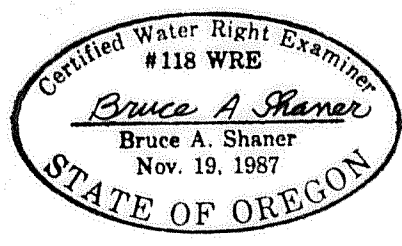

Scale: 1" = 400 ft.

September 17, 2001