


JOSEPH McELIGOTT
COBU MAP FOR PERMIT R-11929
T5S, R26E, W.M., MORROW COUNTY

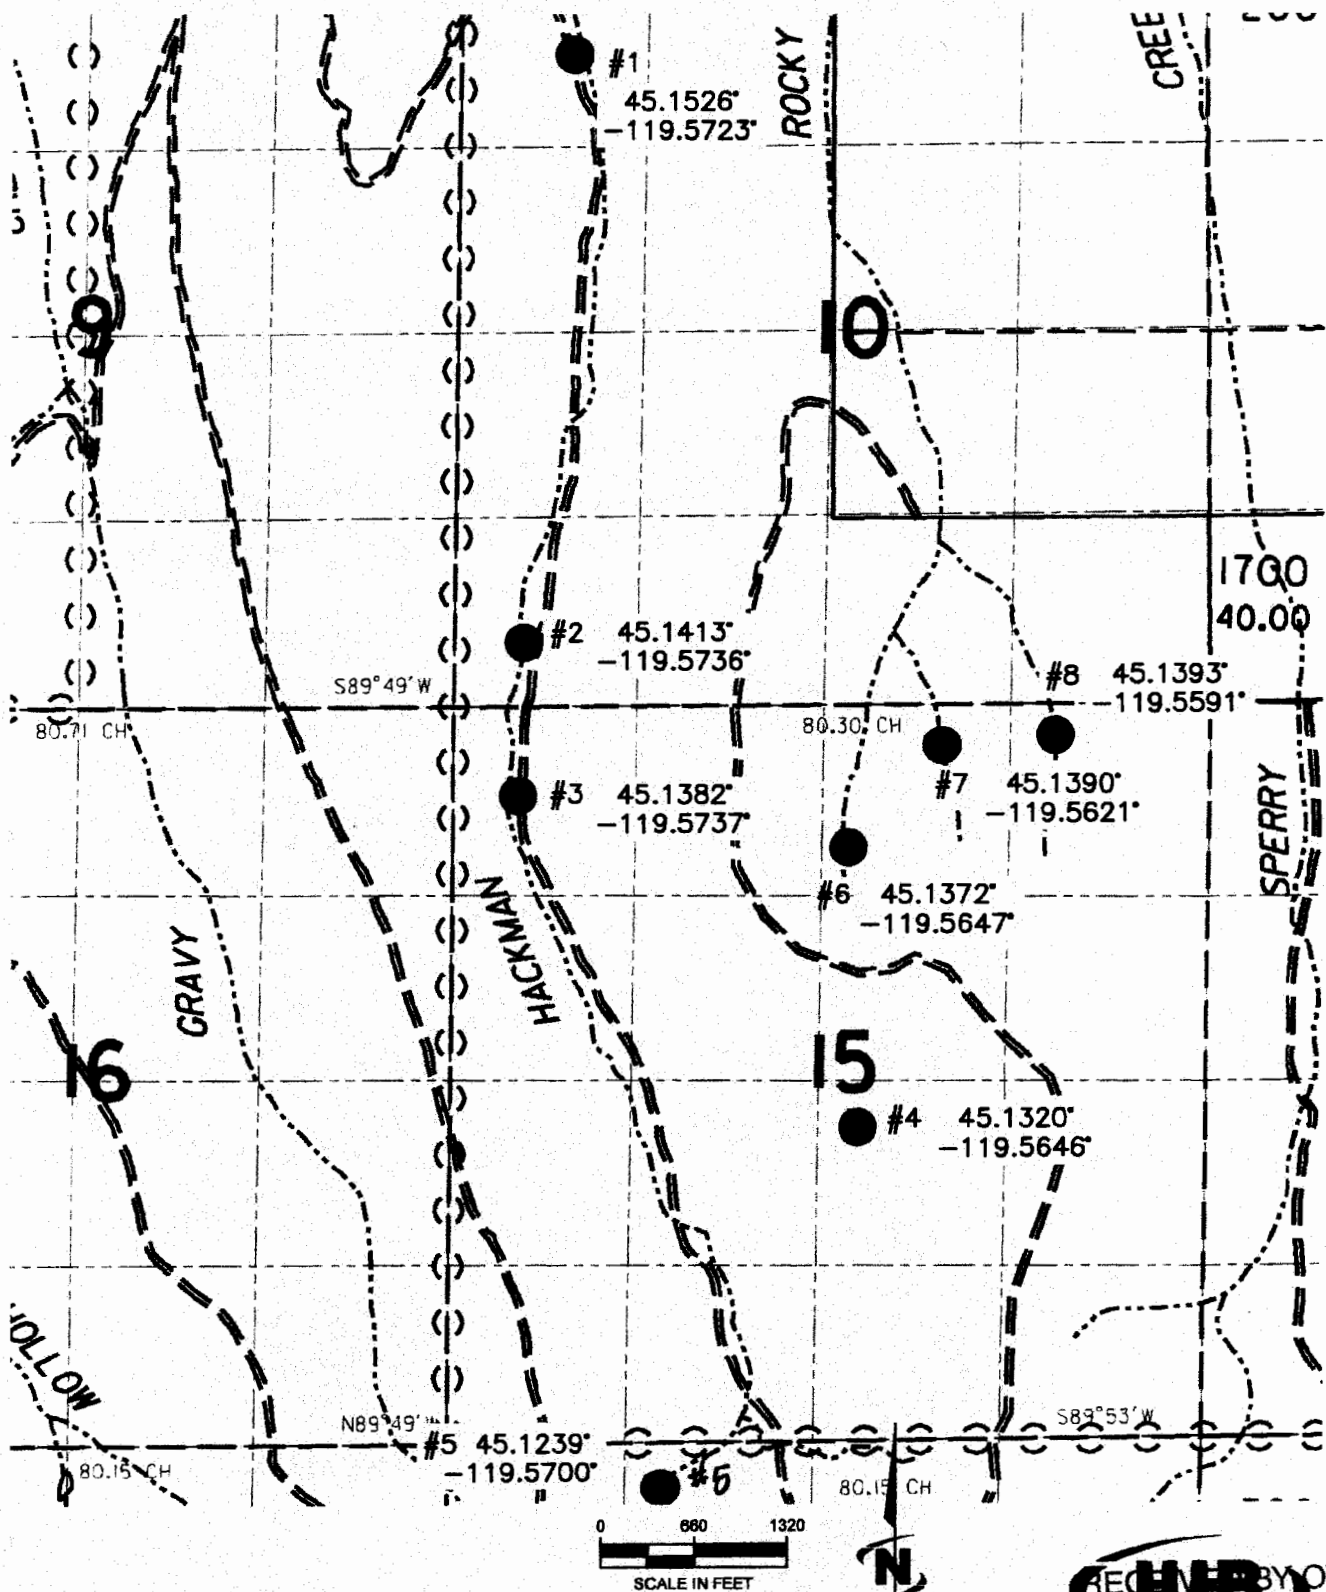

NOTE:
THE PURPOSE OF THIS MAP IS TO IDENTIFY THE APPROXIMATE LOCATION OF THE WATER RIGHT. IT IS NOT INTENDED TO PROVIDE INFORMATION RELATIVE TO THE LOCATION OF PROPERTY OWNERSHIP BOUNDARY LINES.

DRAWING: \\wkfiles\public\Project\30-08-016 - Porfly Water Rights Consulting\--00 Misc Engineering\Cad\McElligott\30-08-016 McEl.dwg
PRINTED BY: willard on 09/29/14 01:06 PM

REC'D BY OWRD
JUB
J-U-B ENGINEERS INC.
OCT 08 2014

SALEM, OR