


T4S R5W, WM

YAMHILL COUNTY

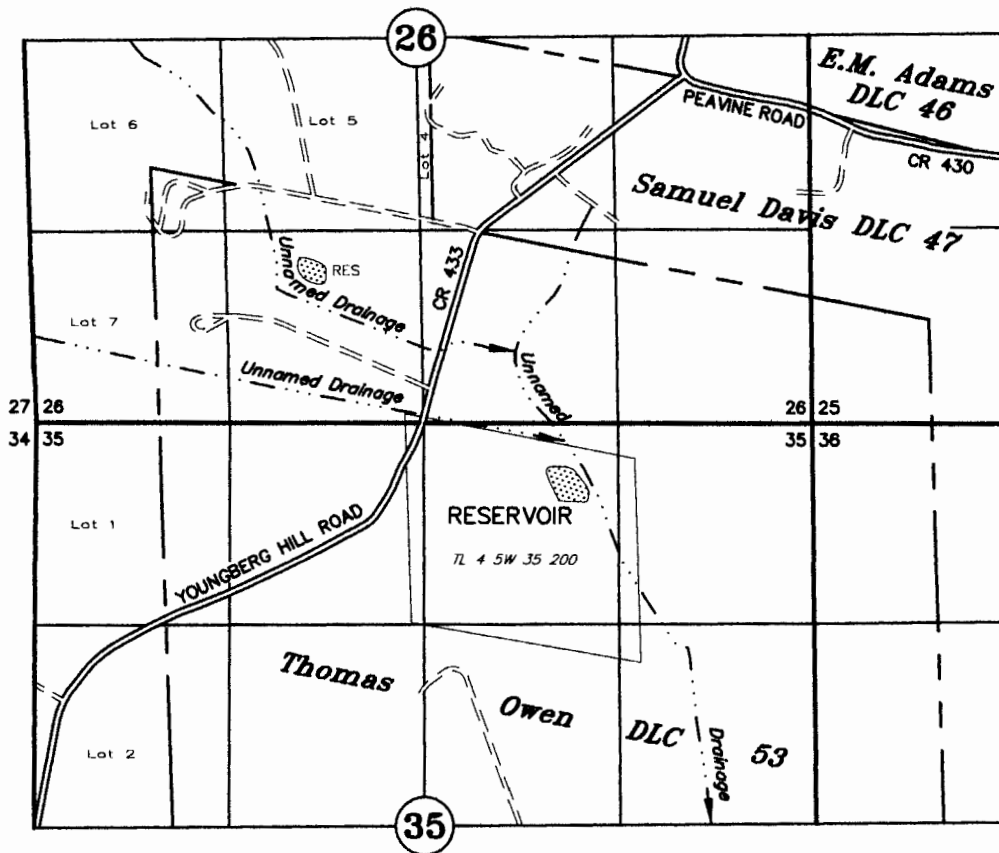

DAM: 500' SOUTH & 1550' WEST OF NE COR. SECTION 35

CLAIM OF BENEFICIAL USE

UNDER

Application No. R-86611

Permit No. R-14316

Clarke Ellingson

February 18, 2015

SCALE: 1" = 1320'

RECEIVED

MAR 13 2015

NOTE: This map is for the purpose of identifying the location of water rights and has no intent to dimension or locate property ownership lines.

WATER RESOURCES DEPT
SALEM, OREGON