


RECEIVED BY OWARD

MAR 21 2014

SALEM, OR

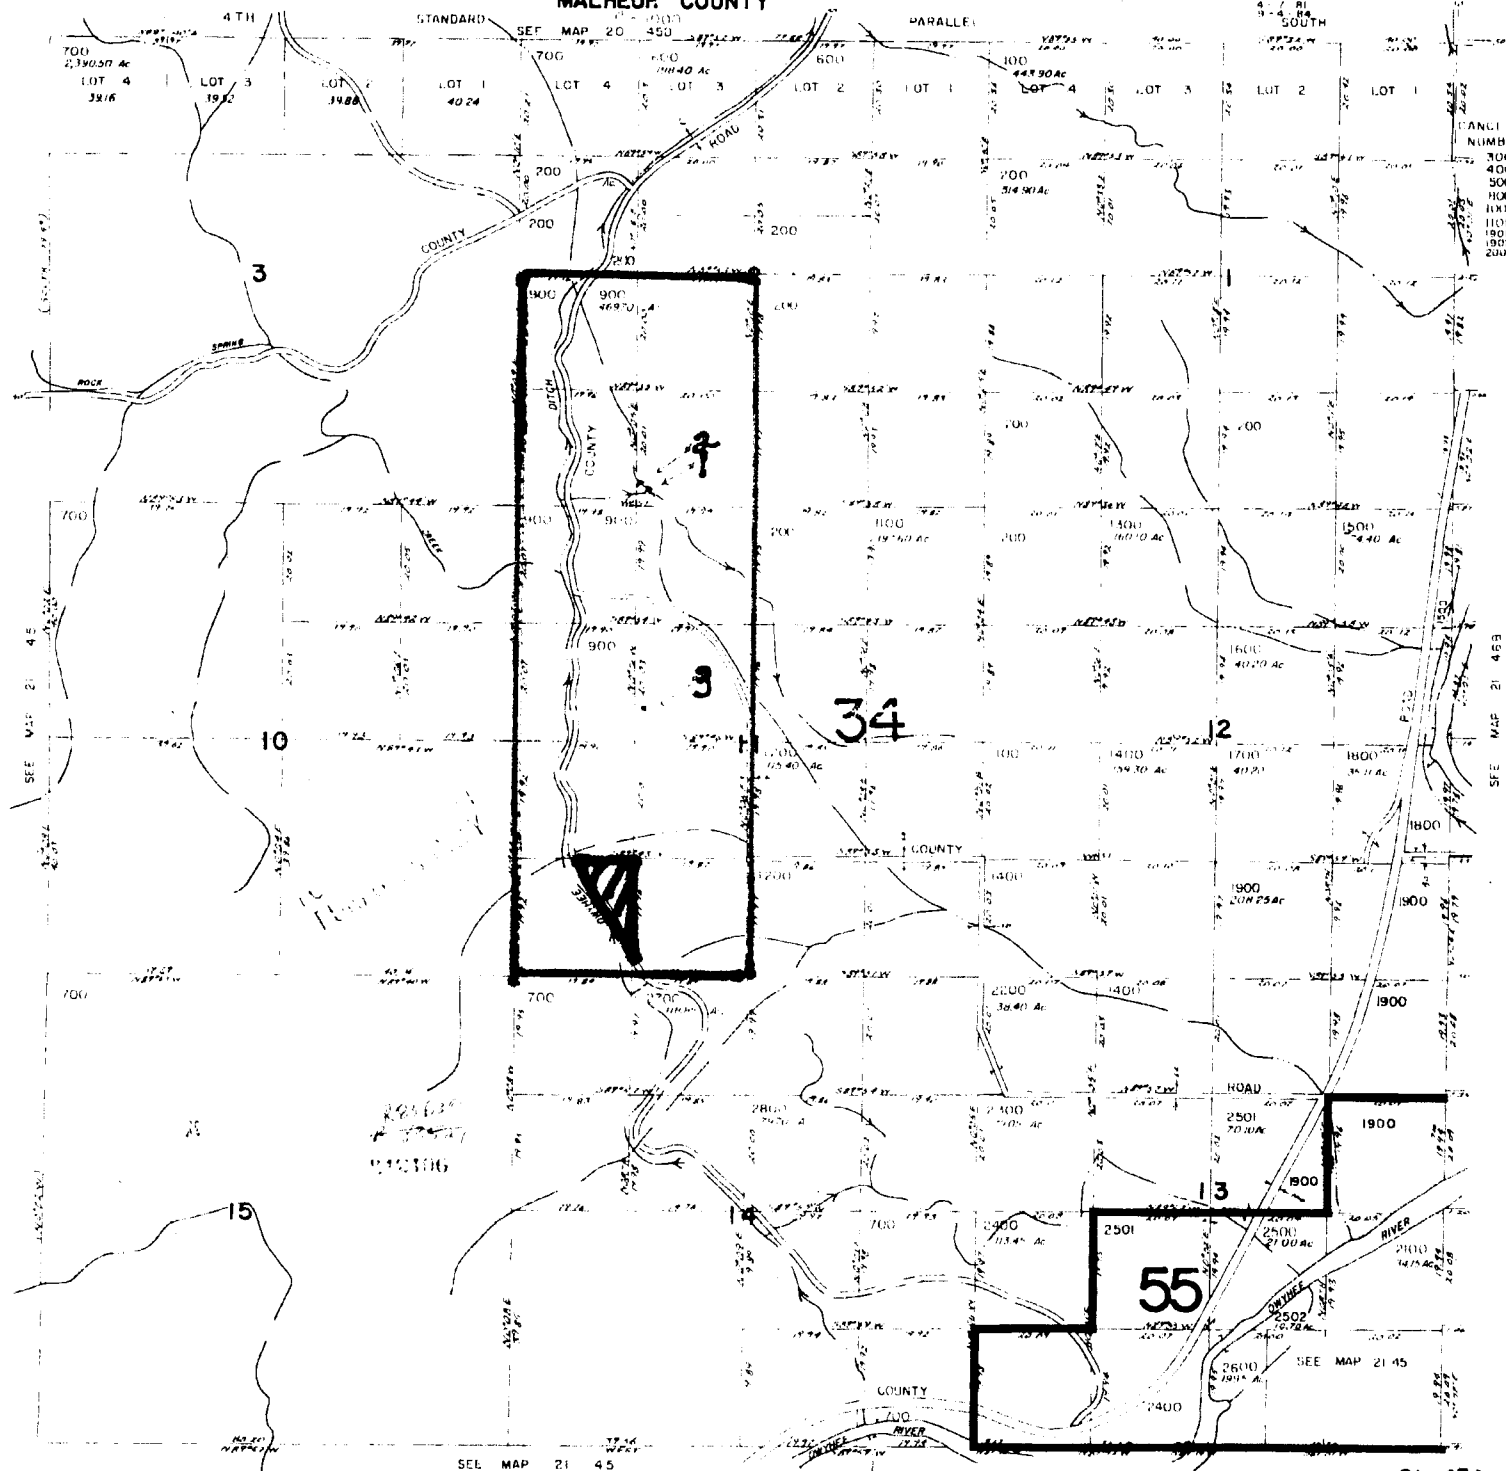

21 45A