



T. 14 S., R. 9 E., W. M.

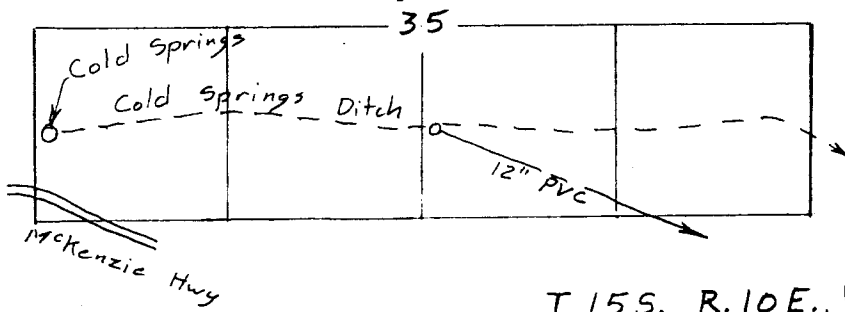

T. 15 S., R. 10 E., W. M.

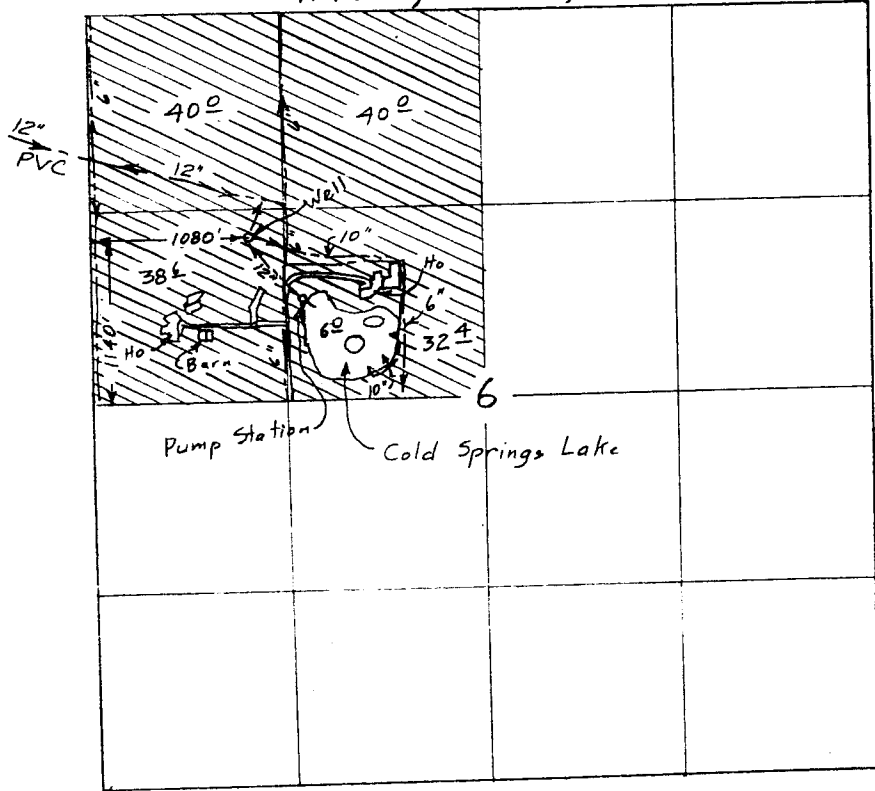

Scale 1" = 1320'

Surveyed Sep 29, 2002

RECEIVED
 OCT 01 2002
 WATER RESOURCES DEPT
 SALEM, OREGON

Claim of Beneficial Use Map
 for
 Janet Reed, William Reed & Myron Reed

Applications	Permits
65516	47945
R-71775	R-11448
71776	51431
G-12621	G-11456

Certified Water Right Examiner
 #1
Bruce A. Estes
 Bruce A. Estes
 Nov. 19, 1987
 STATE OF OREGON
 Renewal Dec 31, 2003

ESTES SURVEYS
 PO Box 17519
 Salem, OR 97305-7519
 (503) 585-7593
 80382 Arnold Rd
 Bend, OR 97702
 (541) 382-7391

This map is for the purpose of locating a water right only and has no intent to provide legal dimensions or the location of property lines.