


12	1	R.29E.
7	6	R.30E.

100 000 000

WATER RESOURCES DEPT
SALEM OREGON

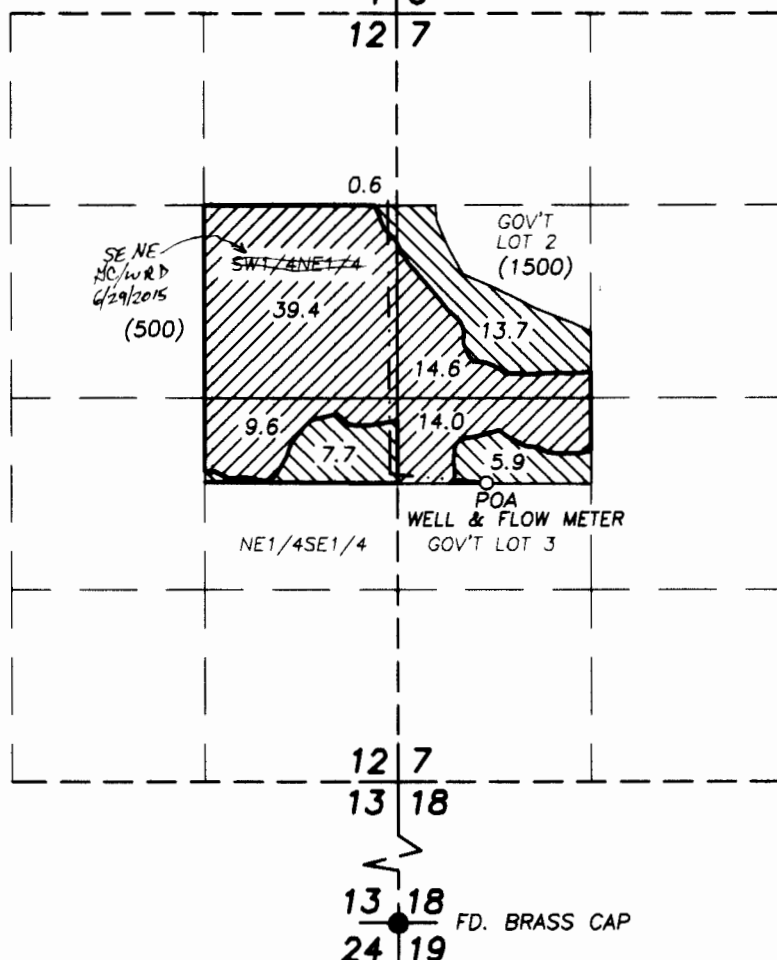

SCALE 1"=1320'

FINAL PROOF SURVEY
UNDER APPLICATION NO. G-15237, PERMIT NO. G-15108
IN NAME OF
PAT AND MARY BURKE

SURVEYED SEPTEMBER 5, 2006 BY ROBERT BAGETT
MAP REVISED NOV. 29, 2007 BAGETT, GRIFFITH & BLACKMAN
TAX LOT NO. PROFESSIONAL LAND SURVEYORS
P.O. BOX 476
MAIN LINE JOHN DAY, OREGON 97845
(541) 575-1251

— . . — MAIN LINE

PRIMARY RIGHT

SUPPLEMENTAL RIGHT

NOTE: The preparation of this map was for the purpose of identifying the location of the proposed water right and has no intent to provide dimensions or location of property ownership lines.

